


Ellis

KANSAS

SECTION 7 TOWNSHIP 14 RANGE 19W

WELL NO. #2 Kramer

COMPANY Chief Drlg.

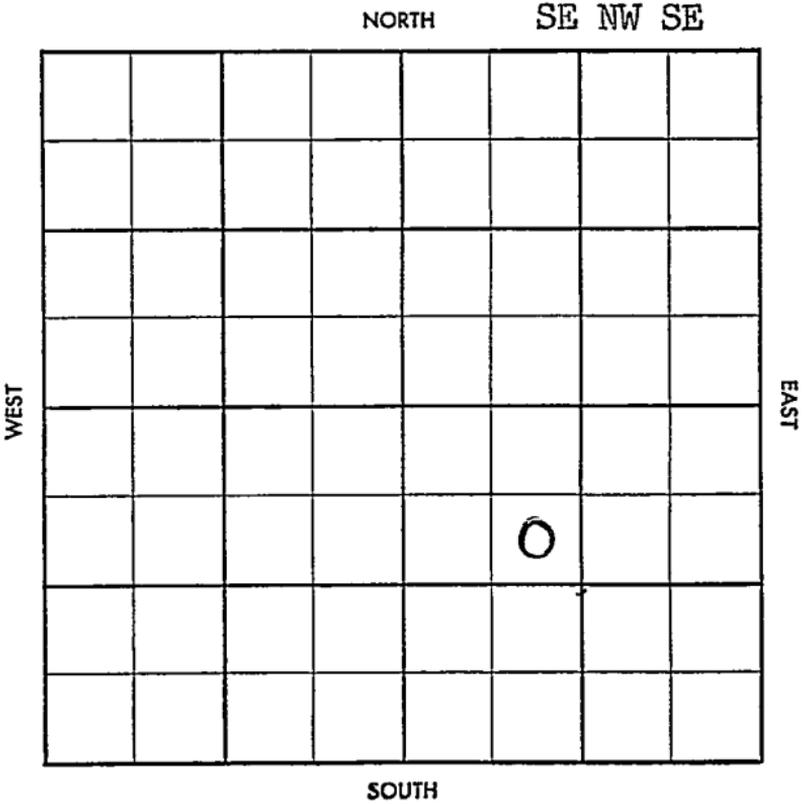

CO. ~~Elvis~~ ELEV. 2230
SEC. 7 TWP. 14 RGE. 19W
COMPANY Chief Drlg. NO. 2

COMPLETE
DEC 18 57

FARM Kramer

LOC. SE NW SE

1/2 3486
TR 3570
L 3532 1302
BKC 3783 1553
March 3820 1590
" sd 3838 1608
A 3856 1626
TD 3870

GEOL.
CONTR Co. tools
POOL S. Irvin
SPUD 10-8-57
R I R of 15 27
8" 205/150
3775
DST 3840 -55
90" 20' HOCM
35' OCM BHP 1040

DST 3858-70 90" 200' OCM
BHP 1120/30" 5 1/2 3857
CO 3870 \$ 3 B MCO ph 1 hrs
\$ 1.67 B O ph NW 4 hrs
Nat 250A \$ 2 1/2 B O NW
1/2 hr \$ 4.14 B O ph NW 7 hrs
POP NOV 20 57 P 42 B O ph NW

PHY P 25 B O ph 2 + 6500 W
arb 92.34.80

CO
LSE
NO.
SEC.
TWP.
RGE.