


Ellis

KANSAS

SECTION 7 TOWNSHIP 14S RANGE 19W

WELL NO. #1 Riedel

COMPANY Burch Drlg. Co.

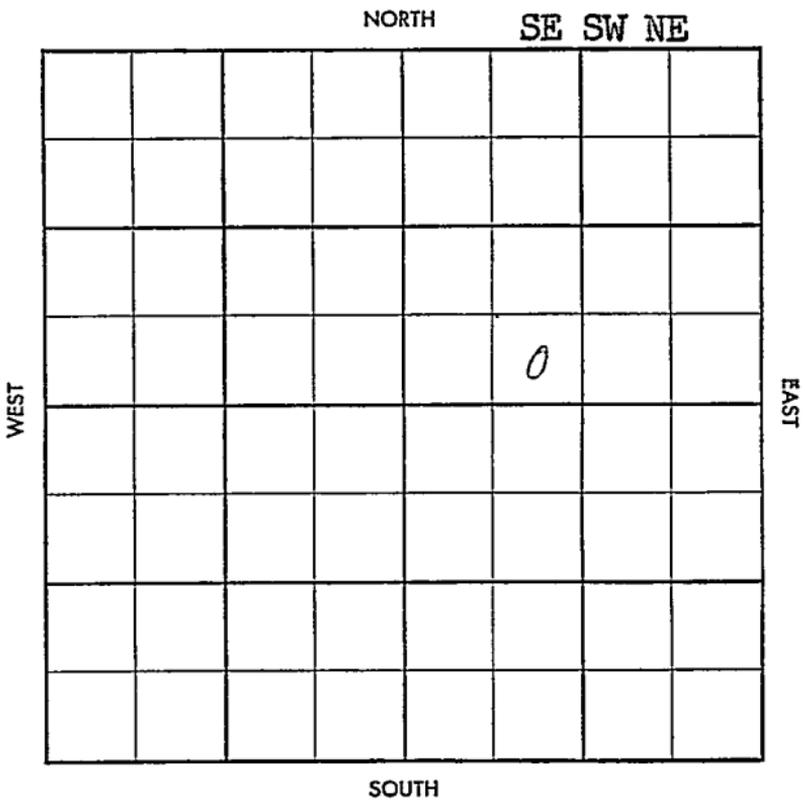

Twp. ~~XXXX~~ P. ~~XXXX~~

Co. ~~XXXX~~ P. ~~XXXX~~

WILDCAT

S-513-B

County Ellis Elev. _____

Sec. 7 Twp. 14 Rge. 19W

Company Burch Drlg. Co.

Farm Name Riedel No. 1

TOPS	DEPTH	LOG	DATUM
Anh.			
Tp.			
H.			
Tr.			
Dg.			
B.L.			
L.			
K.C.			
B.K.C.			
Ce.			
C.			
M.			
M.			
K.			
Mz.			
Mq.			
V.			
S.			
S.			
A.			
R.			
Pf.			
G.			
T.D.			

Loc. in Sec. _____

SE SW NE

Geol. _____

Contr. _____

Co. Tools

Pool _____

Wildcat

APR 2 1958

FIRST REPORT

Date Comm. 3/28/58

8" @ 220, Drlg. 1100

Co.

Use.

No.

Sec.

T.

R.


~~Top~~ ~~Foot~~
~~No~~ ~~Foot~~

S-513-B

County Ellis Elev. 22500F 225340
 Sec. 7 Twp. 14 Rge. 19W
 Company Burch Drig. Co.
 Farm Name Riedel No. 1

TOPS	DEPTH	LOG	DATUM
Anh.	1528		
Tp.			
H.	3497		
Tr	3520		
Dg.			
B.L.			
L.	3539		
K.C.			
B.K.C.	3796		
Ce.			
C.	3832		
M.			
M.			
K.			
Mz.			
Mq.			
V.			
S.	3982		
S.	3885		
A.	3897		
R.			
Pf.			
G.			
T.D.	3903		

Loc. in Sec. SE SW NE
 Geol. X
 Contr. _____
 Co. Tools _____
 Pool IRVIN
Wildcat

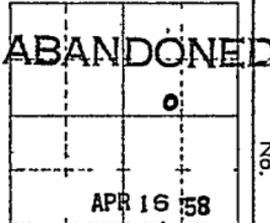

Date Comm. 3/28/58
 S# @ 220, Drig. 1100 APR 9 '58 DST 3535-80
 op 1hr 45' SW BHP 963 DST
 3600-35 op 1hr 40' 06 gcm
 90' SW BHP 1020 d 36 40
 APR 16 '58 DST 3669-87 op 1hr 20'M
 BHP 53/30" DST 3691-3712 op 1hr 9'M BHP
 35/30" DST 3872-93 op 1hr 5' 50cm
 16'M BHP 440/30" DST 3897-3903 op 90"
 310' SW BHP 1145/30" no log D-6A