


Section 27 Township 13 Range 14 W

Well No. #9 Shaffer SWD

Company Eldorado & Shields

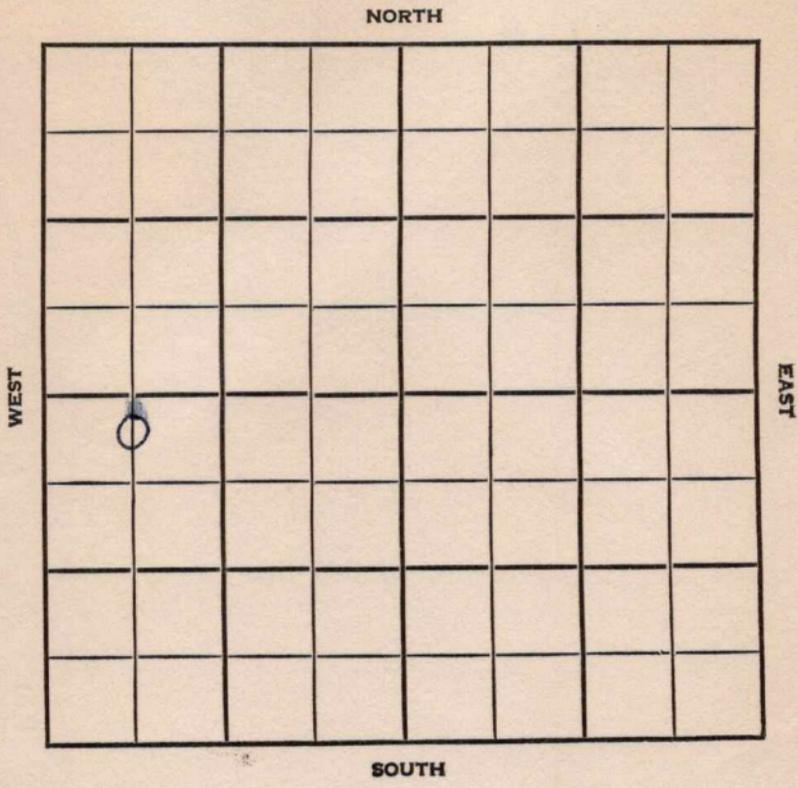

Russell

KANSAS

|            |            |           |
|------------|------------|-----------|
| SEC.<br>27 | TWP.<br>13 | R.<br>14W |
|------------|------------|-----------|

WELL NO.

#9 Shaffer SWD

FARM

COMPANY

El Dorado & Shields

CONTRACTOR

Shields  
Russell


\_\_\_\_\_ Ft. from N. Line

\_\_\_\_\_ Ft. from S. Line

\_\_\_\_\_ Ft. from E. Line

\_\_\_\_\_ Ft. from W. Line

C N  $\frac{1}{2}$  NW SW

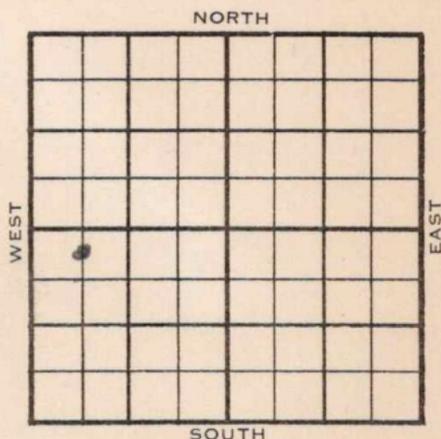

1955

ELEVATION  
1847'

REPORT  
FIRST REPORT

8/10

Comm 8-7-55  
Drlg600

9-7

8 5/8" @ 880 w/375  
DST 3263-73 open 30", rec 300' fluid  
5% oil BHP 915 4 1/2" 3315  
CO 3504 input 1.15 bwph for 1 hr. input  
115 bwph 1 hr 1000 acid  
Complete SWD

| <u>TOPS</u> | <u>DEPTH</u> |
|-------------|--------------|
| H           | 2942         |
| Tr.         | 2960         |
| L.          | 2997         |
| A           | 3263         |
| R.          | 3294         |

~~Tr.~~

ABANDONED

County Russell Elev. \_\_\_\_\_  
 Sec. 27- Twp. 13 Rge. 14W  
 Company Eldorado & Shields  
 Farm Name Shaffer SWD No. 9

| TOPS   | DEPTH | LOG | DATUM |
|--------|-------|-----|-------|
| Anh.   |       |     |       |
| T.P.   |       |     |       |
| H.     |       |     |       |
| Tr.    |       |     |       |
| Dg.    |       |     |       |
| Bl.    |       |     |       |
| L.     |       |     |       |
| K.C.   |       |     |       |
| B.K.C. |       |     |       |
| Ce.    |       |     |       |
| C.     |       |     |       |
| M.     |       |     |       |
| M.     |       |     |       |
| K.     |       |     |       |
| Mz.    |       |     |       |
| Me.    |       |     |       |
| V.     |       |     |       |
| S.     |       |     |       |
| S.     |       |     |       |
| A.     |       |     |       |
| R.     |       |     |       |
| Pe.    |       |     |       |
| G.     |       |     |       |
| T.D.   |       |     |       |

Loc. in Sec. C N $\frac{1}{2}$  NW SW  
 Geol. \_\_\_\_\_  
 Contr. Shields  
 Pool Russell

AUG 10 55  
 FIRST REPORT

Date Comm. 8-7-55  
 drlg. 600

13

Co.  
 Lse.  
 No.  
 Sec.  
 T.  
 R.

County Russell Elev. 1847  
 Sec. 27 Twp. 13 Rge. 14W  
 Company Eldorado & Shields  
 Farm Name Shaffer SWD No. 9

| TOPS   | DEPTH       | LOG | DATUM       | Loc. in Sec.   |
|--------|-------------|-----|-------------|--|
| Anh.   |             |     |             | C N/2 NW SW  |
| T.P.   |             |     |             |  |
| H.     | <u>2942</u> |     | <u>1095</u> |  |
| Tr.    | <u>2960</u> |     | <u>1113</u> |  |
| Dg.    |             |     |             |  |
| Bl.    |             |     |             |  |
| L.     | <u>2997</u> |     | <u>1150</u> | Geol. _____  |
| K.C.   |             |     |             | Contr. _____   |
| B.K.C. |             |     |             | Shields  |
| Ce.    |             |     |             |  |
| C.     |             |     |             | Pool _____   |
| M.     |             |     |             | Russell  |
| M.     |             |     |             |  |
| K.     |             |     |             |  |
| Mz.    |             |     |             |  |
| Me.    |             |     |             |  |
| V.     |             |     |             |  |
| S.     |             |     |             |  |
| S.     |             |     |             |  |
| A.     | <u>3263</u> |     | <u>1416</u> | <div style="border: 1px dashed black; padding: 5px; text-align: center;">                 ABANDONED             </div> |
| R.     | <u>3294</u> |     | <u>1447</u> |  |
| PE.    |             |     |             |  |
| G.     |             |     |             |  |
| T.D.   |             |     |             |  |

Date Comm. 8/7/55 SEP 7 1955

8 5/8" 880 w/375 DST 3263-73 open 30"  
Rec. 300' fluid 5% oil BHP 915 4 1/2" 3315  
CO 3504 input 1.15 bwph for 1 hr input  
115 bwph 1 hr 1000 acid Complete SWD

Co.  
Sec.  
No.  
Sec.  
T.  
R.