


Ellis

Section 8 Township 14 Range 19W

Well No. 1 C. Reidel

Company Lewis Drlg.

NORTH

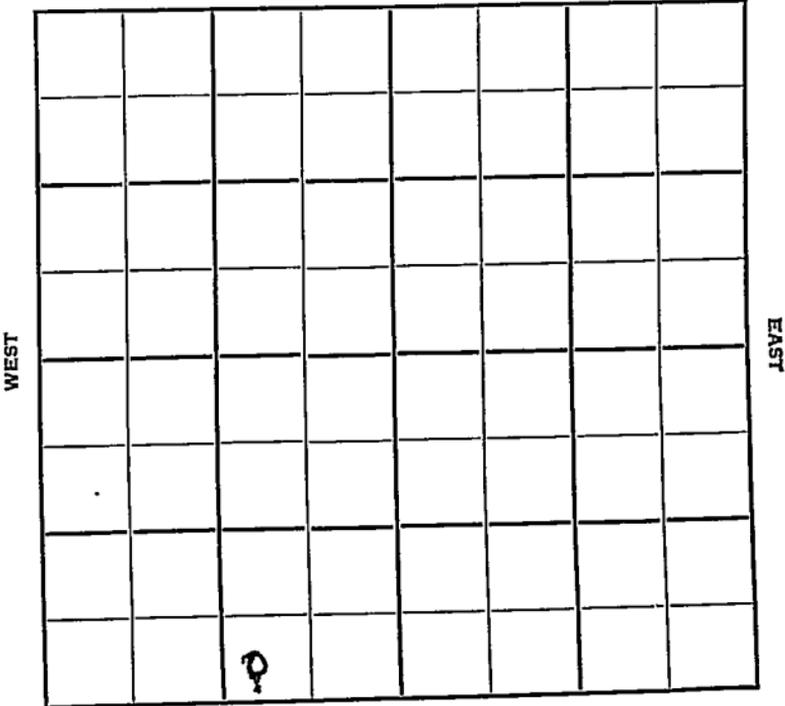

SOUTH

Sec. 8 Twp. 14 R. 19 W

Well No. # 1 C. Reidel Farm

Lewis Drlg. Company

Contractor

Wildcat


 Ft. from N. Line

330 Ft. from S. Line

990 Ft. from E. Line

 Ft. from W. Line

SW SE SW

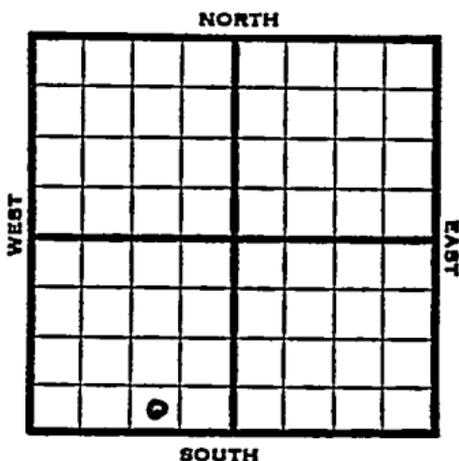

1952 Elev. 2208' REPORT

12/17 Cellar & Pits
 12/18 C&P
 12/25 C&P
 1/1 Drlg.
 1/8 8" @ 160 Heeb 3461 KC 3506 DST 3704 14
 1 Hr. 15' M 1150# Cong. 3775 Arb 3837
 DST 3832-49 1 Hr. 10' Oil 16 Hly
 COM 945 # RTD 3849 5" @ 3839

1/22 CO 3849' 500 A S/8 BOPH 6 hrs.
 P/8 BOPH

1/29 NR
 2/5 NR

2/11 Oil Well
 TD 3849
 8" @ 160
 Heeb 3461, KC 3506
 DST 3704-14, opn 1 hr., rec.
 15' mud, 1150#
 Cong 3775, Arb 3837
 DST 3832-49, opn 1 hr., rec.
 10' oil, 16' hocm, 945#
 TD 3849,
 5" @ 3839,
 CO to 3849, 500A S/8 boph
 6 hrs., P/8 boph
 Comp. 181 bopd 6% wtr

COMPLETED

