

Ellis

14


19W

Section 7 Township _____ Range _____Well No. #1 WannCompany Lewis Drlg.

NORTH

WEST

EAST

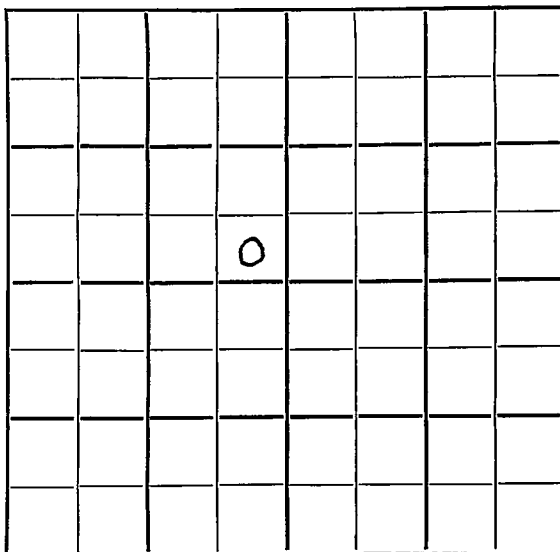

SOUTH

Ellis

KANSAS

Sec. 7 Twp. 14 R. 19

Well No. #1 Wann Farm

Lewis Drlg.

Company

Lewis Drlg.

Contractor

Irvin Pool

Ft. from N. Line

330

Ft. from S. Line


330

Ft. from E. Line

Ft. from W. Line

SE SE NW

Stano.- acreage

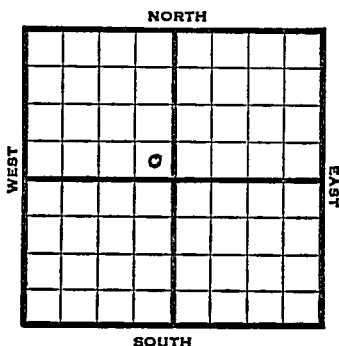

1953

Elev. 2243'

REPORT

5/6

Spud 5-5-53
Rng. surface pipe.

5/21

8" @ 150 Heeb 3504 Lans 3548
DST 3738-54, 1 hr, 15' M Arb. 3880
DST 3881-86, 1 hr, 8' OCM 700#
RTD 3886 Schl 5" @ 3881

5/28

DD 3891 sd-frac. S/ 1 BO / 1 BW 1 Hr

6/3

Spud 5-5-53
D & A
TD 3904'
8" @ 150'
Heeb 3504, Lans 3548'
DST 3738-54 opn 1 hr, rec 15' mud 40#
Arb 3880
DS^T 3881-86 opn 1 hr, rec 8' ocm 700#
TD 3886'
5" @ 3881'
DD 3891 sd-ffac S/ 1 bo 1 bw 1 hr.
S/ 3 bw $\frac{1}{2}$ boph DD 3904 HFW
D & A

ABANDONED

County Ellis State Kansas
 Sec. 7 (Blk.) 14 (Sur.) 19W Map No.
 Operator Lewis Drlg.
 Well No. 1 Farm Wann

Elev. _____ Location SE SE NW



330 Ft. From S Line NW
330 Ft. From E Line Quarter
 1st. Report MAY 6 1953

Completion _____

Remarks Stano. - acreage


Lewis Drlg. - Contr.

Spudding Date 5-5-53

Drlg. Data Irvin Pool

eng. surface pipe

J. G. McGEHEE

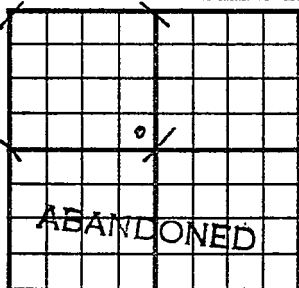County Ellis State KansasSec. 7 (Blk. 14 (Sur. 19W Map No.)
(Twp.) (Rge.)Operator Lewis Drlg.Well No. 1 Farm WannElev. 2243 Location SE SE NW330 Ft. From S Line NW330 Ft. From E Line Quarter1st. Report Completion JUN 3 1953Remarks Irvin PoolLewis Drlg. - Contr.Spudding Date 5-5-53Drlg. Data D & A TD 39048" @ 150 Heeb. 3504 Lans. 3548DST 3738-54 open 1 hr. Rec. 15' mud40# Arb. 3880 DST 3881-86 open 1 hr.Rec. 8' ocm 700# TD 3886 5" @ 3881DD 3891 sd-frac S/ 1 bo 1 bw 1 hr.S/ 3 bw $\frac{1}{2}$ boph DD 3904 HFWD & A