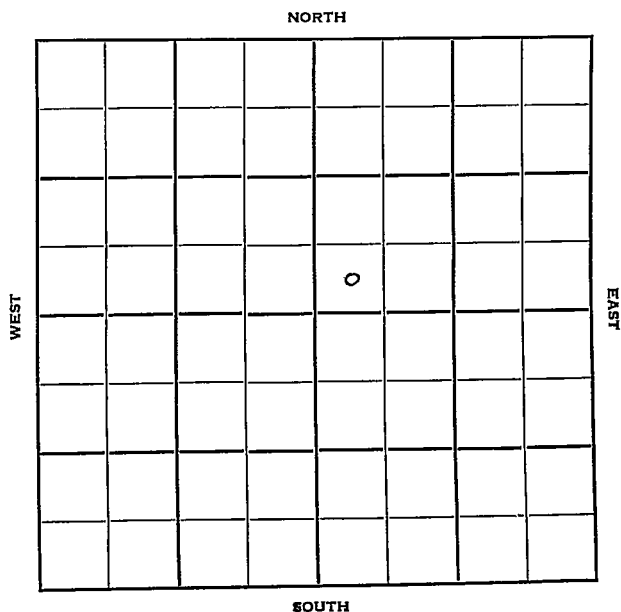


Section 8 Township 14 Range 19-WWell No #1 KinderknachtCompany Derby Oil et al

Ellis

KANSAS
19W

Sec. 8 Twp. 14 R. 19W

Well No. #1 Kinderknacht Farm

Derby Oil et al Company

Wildcat Contractor

Ft. from N. Line

330'


Ft. from S. Line

Ft. from E. Line

330'

Ft. from W. Line

SW SW NE

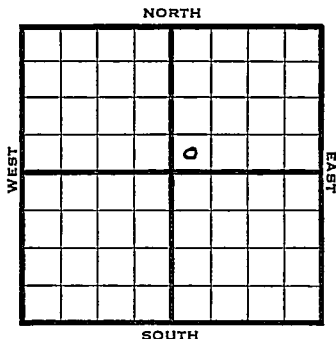

1950

Elev 2213

REPORT

6/28

Location

7/19

13 3/8" @ 129

Heeb 3473

Do1 3496

Lans 3520

BKG 3766

Ch Cong 3818

Sd Cong 3848

TD 3884

D&A

ABANDONED

Map No. _____ Sec. 8 Twp. 14 R. 19WWell No. 1 Kinderknacht

Derby Oil etal. _____ Company

Contractor _____

SW SW NE

SECTION PLAT

_____ Ft. from N. Line

330 Ft. from S. Line

_____ Ft. from E. Line

330 Ft. from W. Line

Ellis County

Stanolind farmout

Location X

Rig up _____

Drilling and Remarks:

RECORD

Cased _____ in., _____ ft.

Sand _____

Gas _____

Oil _____

Total Depth _____

PRODUCTION

1st 24 hrs. Nat. _____

1st 24 hrs. after shot _____

Gas _____ Cu. Ft.

Dry Hole _____

Abandoned _____

Date

JUN 28 1950 19J. E. TYRA Scout

Map No. _____ Sec. 8 Twp. 14 R. 19W

Well No. 1 Kinderknichet


Derby Oil etal.

Company

Contractor

SW SWNE

E1. 2213
SECTION PLAT

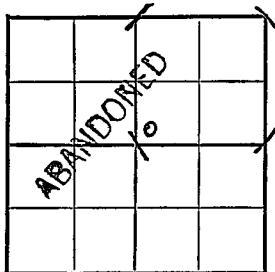

_____ Ft. from N. Line

330 Ft. from S. Line

_____ Ft. from E. Line

330 Ft. from W. Line

Ellis County

Location _____

Rig up _____

Drilling and Remarks:

13 3/8" @ 129

Heeb. 3473

Dol. 3496

Lans. 3520

B KC 3766

Ch. Cong. 3818

Sd. Cong. 3848

RECORD

Cased _____ in., _____ ft.

Sand _____

Gas _____

Oil _____

Total Depth 3884

PRODUCTION

1st 24 hrs. Nat. _____

1st 24 hrs. after shot _____

Gas _____ Cu. Ft.

Dry Hole _____

Abandoned _____

ED 3884

Date D & A

JUL 10 1950 19

J. F TYP

Scout