

Russell

FORM 51

KANSAS

Section 27 Township 13 Range 11W

Well No. #1 Thurlow

Company Shields Oil Prod.

NORTH

WEST

EAST

0

SOUTH

Russell

KANSAS

SEC.	TWP.	R.
27	13	14 W

WELL NO. # 1 Thurlow FARM

COMPANY Shields Oil Prod.

CONTRACTOR Co. tools


Russell Townsite

990 Ft. from N. Line

Ft. from S. Line

Ft. from E. Line

330 Ft. from W. Line

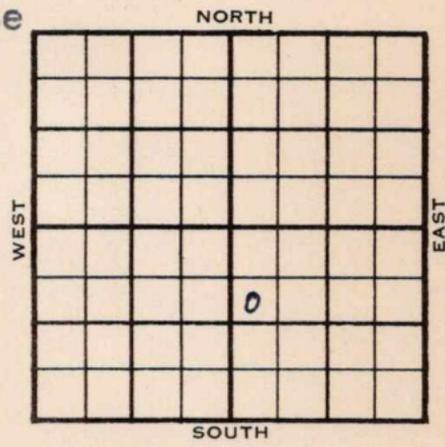

SW NW SE

	ELEVATION	REPORT
1954	1848'	
3/17	Spud 3-15-54	
3/24	8" @ 203 w/100 Anhy 885 Drlg. 2575'	
3/31	Lans 3098 Arb. 3270 RTD 3279 5" @ 3273	
4/7	Spud 3-15-54 Oil Well TD 3279' 8" @ 203' Anhy 885', Lans 2998', Arb. 3270' TD 3279' 5" @ 3273' CO to 3276', SSO, XIX 500A S/4 boph 1000A Comp. 50 bopd	

COMPLETED

County **Russell** State **Kansas**

Sec. **27** (Blk.) **13** (Sur.) **14W** Map No.
 (Twp.)

Operator **Shields Oil Prod.**

Well No. **1** Farm **Thurlow**

Elev. Location **SW NW SE**

990 Ft. From **N** Line **SE**

330 Ft. From **W** Line Quarter

1st. Report **MAR 17 1954**

Completion

Remarks

Co. tools

Spudding Date **3-15-54**

Drlg. Data **Russell Townsite**

