


Section 27 Township 13 Range 11W

Well No. #1 Vanderdur

Company Driscoll et al

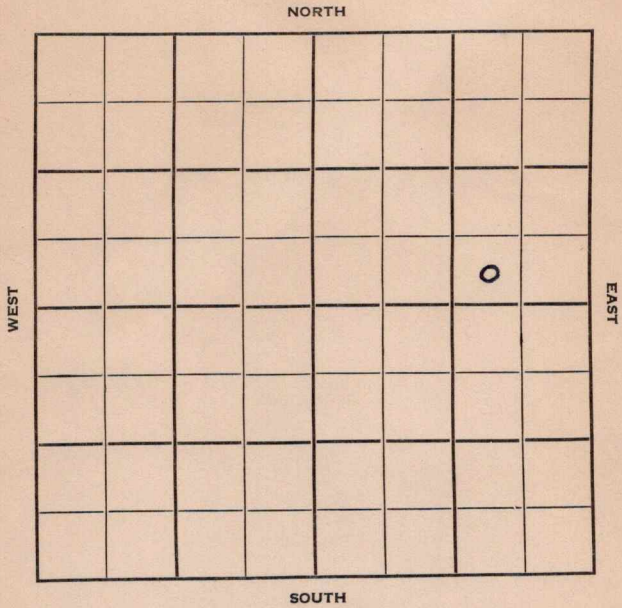

Russell

KANSAS

Sec. 27 Twp. 13 R. 14 W

Well No. # 1 Vanderdur (Vanderbeer) Farm

Driscoll et al Company

Stearns Drlg. Contractor


Ft. from N. Line

330 Ft. from S. Line

990 Ft. from E. Line

Ft. from W. Line

SW SE NE

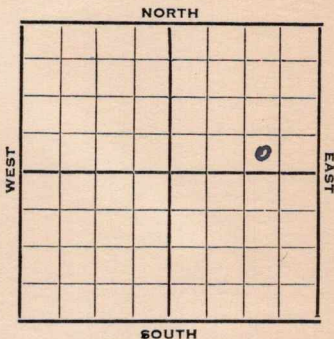

1952

Elev. 1831' REPORT

10/15 Spud 10-11-52
8" @ 245'
Drlg. 389'

10/22 Drlg. 2953'

10/29 Anhy 851' Topeka 2702' Heeb 2923'
Lans. 2979' Arb. 3255' RTD 3258'
5" @ 3256'

11/5 DD 3265-TD FU 1700' oil lh rs.
no wtr.

11/12 Spud 10-11-52
Oil well TD 3265' 8" @ 245'
Anhy 851' Top. 2702' Heeb 2923'
Lans. 2979' Arb. 3255'
TD 3258' 5" @ 3256' DD 3265'
FU 1700' oil 17 hr.
Comp. 50 BOPD

COMPLETED

County Russell State Kansas

Sec. 27 (Blk. 13) (Sur. Rge.) 14W Map No.

Operator Driscoll etal.

Well No. 1 Farm Vanderdur

Elev. Location SW SE NE

330 Ft. From S Line NE

990 Ft. From E Line Quarter

1st. Report OCT 15 1952

Completion _____

Remarks _____

Sterns Drlg. - Contr.

Spudding Date 10-11-52

Drlg. Data _____

8" @ 245 drlg. 389

