


Russell

Map No. KANSAS Sec. 28 Twp. 13 R. 14^w

Well No. 4-Ehrlich Farm
Empire Oil Company

_____ Ft. from N. Line
990 Ft. from S. Line
330 Ft. from E. Line
_____ Ft. from W. Line

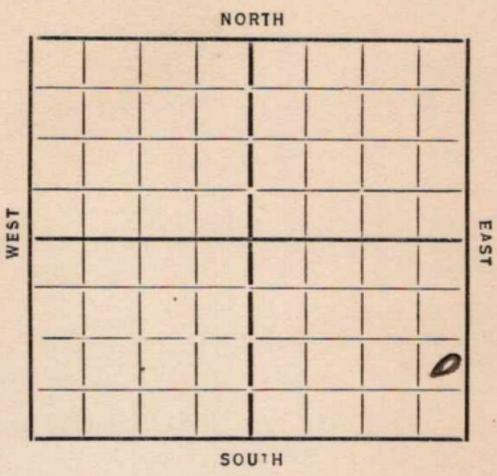

Elev. 1856

Date	REPORT
6/5	Location
6/13	Rig
6/20	Rgn
6/28	15" 366 T 7 405 WR 15"
7/3	dly 855
7/11	Arhey 870 Run 12" 878
7/18	dly 1210
8/8	sh 2400 10" 2525
	dly 2687
8/15	sh 2970-80 8" 3062
	HF W 3091-3115
	dly 3125
8/22	30251 WR 8"
8/29	8" 3233 Sil 3298
	87' 6" liner
	3 Bbls oil per hr 3304-04
9/6	750' Oil 1000 acid
10/3	60 Oil + 60 Wt 24 hrs.
10/10	_____
11/1	SD.
11/7	11/14-11/21 (OVER)

731266

11/27 Sil 3298
TD 3304
D. + A.

ABANDONED

Map No. 72 Sec. 28 Twp. 13 R. 14W

KANSAS

Well No. 4 - Ehrlich

Empire oil Company

Contractor

FIRST REPORTS

SECTION PLAT

Ft. from N. Line

990 Ft. from S. Line

330 Ft. from E. Line

Ft. from W. Line

			0

Location

Rig up

Drilling and Remarks:

RECORD

Cased in., ft.

Sand

Gas

Oil

Total Depth

PRODUCTION

1st 24 hrs. Nat.

1st 24 hrs. after shot

Gas Cu. Ft.

Dry Hole

Abandoned

Date

6-5-35 192

ORVAL MANNSCHECK Scout

Map No. 72 Sec. 28 Twp. 13 R. 14W

Well No. 4-Erblich

Empire oil Company

Contractor

ABANDONED

SECTION PLAT

			0

..... Ft. from N. Line

990 Ft. from S. Line

330 Ft. from E. Line

..... Ft. from W. Line

Location.....

Rig up.....

Drilling and Remarks:

N + A

RECORD

Cased..... in., ft.

Sand oil 3298

Gas.....

Oil.....

Total Depth 3304

PRODUCTION

1st 24 hrs. Nat.....

1st 24 hrs. after shot.....

Gas..... Cu. Ft.

Dry Hole.....

Abandoned.....

Date

11-27-35 192.....

ORVAL MANNSCHECK

Scout