


KANSAS

Russell county

Section 28 Township 13 Range 14W

Well No. #10, Ehslich "A" (Ehrlich "A")

Company Cities Service

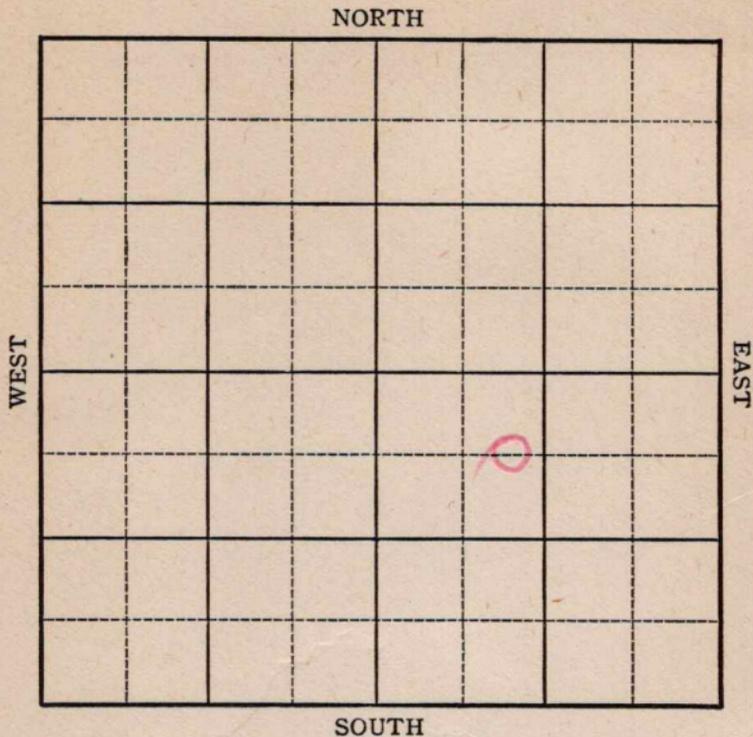

Sec. 28 Twp. 13 R. 14W

Well No. #10 Ehrlich "A" Farm _____

Cities Service Company _____


Russell

800 Ft. from N. Line

_____ Ft. from S. Line

_____ Ft. from E. Line

990 Ft. from W. Line

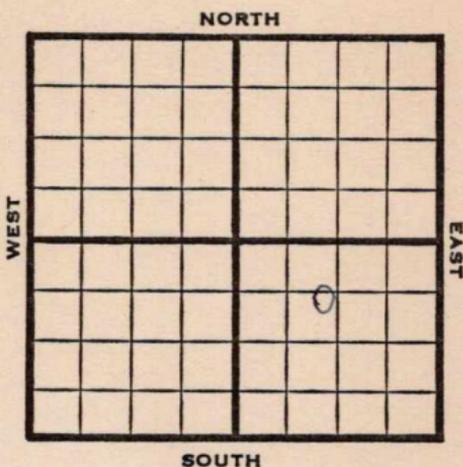

CEL NW SE

1946 **Elev. 1861** REPORT

4/17 1140'

4/23 Drlg 3260'

5/1 **Lans 3016**
Arb 3272-5" @ 3273
TD 3276-2400' oil 8 hrs

5/8 **Arb. 3272**
5" @ 3273
TD 3276'
Pump 271 Pot.
Grav. 36.0

COMPLETED

KANSAS

Kansas Pool Name Russell

Map No. 72 Sec. 28 Twp. 13 R. 14W

Well No. 10 Ehrlich "A"

Cities Service Company

FIRST REPORT Contractor

C E L N W S E


SECTION PLAT

800 Ft. from N. Line

_____ Ft. from S. Line

_____ Ft. from E. Line

990 Ft. from W. Line

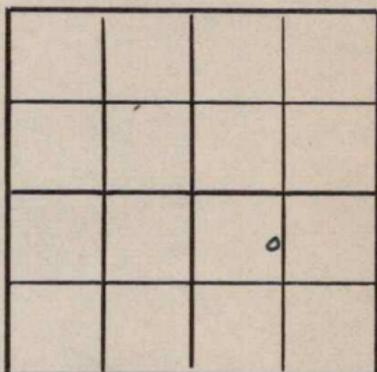

Russell County

Location _____

Rig up _____

Drilling and Remarks:

1140'

RECORD

Cased _____ in., _____ ft.

Sand _____

Gas _____

Oil _____

Total Depth _____

PRODUCTION

1st 24 hrs. Nat. _____

1st 24 hrs. after shot _____

Gas _____ Cu. Ft.

Dry Hole _____

Abandoned _____

Date

APR 17 1946

19

S. J. LEWIS

Scout

