


Section 28 Township 13 Range 14-W

Well Number #7 Ehrlick

Company Empire

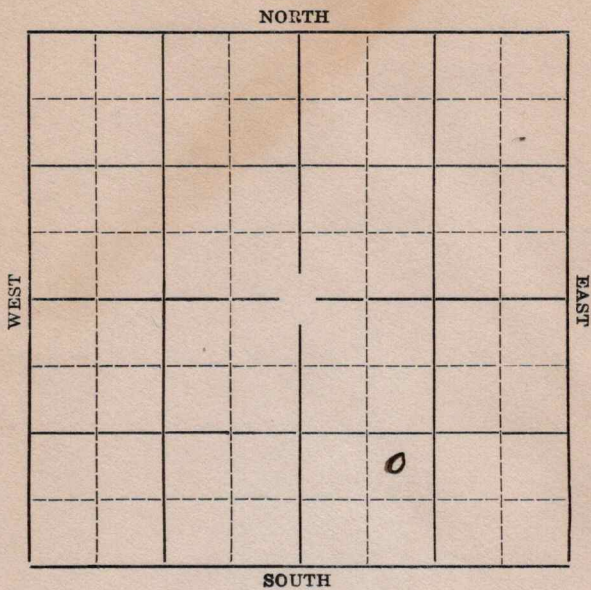

Sec. 28 Twp. 13 R. 14-W

Well No. 7 Ehrlick Farm

Empire Company


_____ Ft. from N. Line

990 Ft. from S. Line

_____ Ft. from E. Line

990 Ft. from W. Line

Elev. 1863

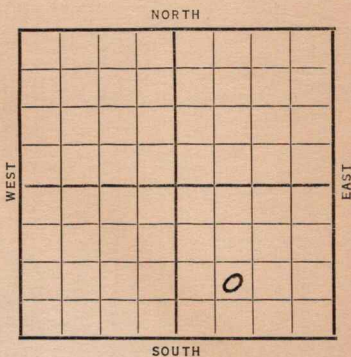

1936

REPORT

11/4 R. O. G.

11/12 Rig

11/19 --

11/27 Drlg. 535'.

12/3 10" @ 600'. Drlg. 900'.

12/10 Drlg. 2185'.

12/17 **Oswald 3020'**. 3058' fishing.

12/24 T. D. 3278'. RUST.

12/29 7" @ 3287'. Drlg. 3294'.

1937

1/7 ----

1/13 **Lansing 3020'**. T. D. 3306'.

154 oil. 3% water.

COMPLETED

KANSAS

Map No. 72 Sec. 28 Twp. 19 R. 14W.

Well No. 7 Ehrlick

Empire Company

Contractor

SECTION PLAT

| | | | |
|--|--|--|--|
| | | | |
| | | | |
| | | | |
| | | | |

_____ Ft. from N. Line

990 Ft. from S. Line

_____ Ft. from E. Line

980 Ft. from W. Line

FIRST REPORT

Location _____

Rig up _____

Drilling and Remarks:

NOG

RECORD

Cased _____ in., _____ ft.

Sand _____

Gas _____

Oil _____

Total Depth _____

PRODUCTION

1st 24 hrs. Nat. _____

1st 24 hrs. after shot _____

Gas _____ Cu. Ft.

Dry Hole _____

Abandoned _____

Date

NOV 4 1936

19

S. J. LEWIS

Scout

Map No. 72 Sec. 28 Twp. 13 R. 14W.

Well No. 7 Ehlers

Empire Company

Contractor

SECTION PLAT

| | | | |
|--|--|--|--|
| | | | |
| | | | |
| | | | |
| | | | |

_____ Ft. from N. Line

990 Ft. from S. Line

_____ Ft. from E. Line

990 Ft. from W. Line

COMPLETED

Location _____

Rig up _____

Drilling and Remarks:

*Licensing 3028
154 oil
3% water*

RECORD

Cased _____ in., _____ ft.

Sand _____

Gas _____

Oil _____

Total Depth 3306

PRODUCTION

1st 24 hrs. Nat. _____

1st 24 hrs. after shot _____

Gas _____ Cu. Ft.

Dry Hole _____

Abandoned _____

Date

JAN 13 1937

19

S. J. LEWIS

Scout