


Section 28 Township 13 Range 14W

Well No. #2 Ehrlich

Company Kim Oil

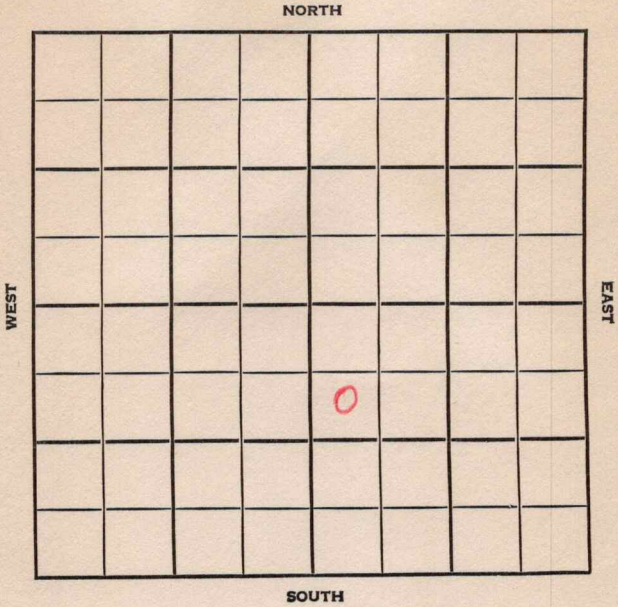

Russell

KANSAS

SEC.	TWP.	R.
28	13	14W

WELL NO. 2 Ehrlich FARM

COMPANY Kim Oil

CONTRACTOR Sidey Atherton Pool


990' _____ Ft. from N. Line

_____ Ft. from S. Line

_____ Ft. from E. Line

330' _____ Ft. from W. Line

SW NW SE

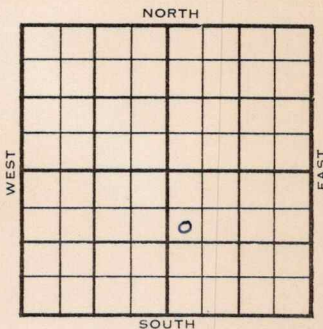

1955 ELEVATION 1861 DF 1863 RB REPORT

5/25 Spud 5-18-55
8" @ 220
Ø 2295'

6/22 Comm 5-18-55
H 2956, L 3011, A 3272, TD 3275
8" @ 220 5 1/2" @ 3274/150
DD 3276 FU 800' oil 1 hr FU 2000'
oil 12 hr Comp 25 bopd

COMPLETED

County Russell Elev. 1863 RB
1861 DF
 Sec. 28 Twp. 13 Rgs. 14W
 Company Kim Oil
 Farm Name Ehrlich No. 2

Co.

TOPS	DEPTH	LOG	DATUM
Anh.			
T.P.			
H.	<u>2956</u>		<u>1093</u>
Tr.			
Dg.			
Bl.			
L.	<u>3011</u>		<u>1150</u>
K.C.			
B.K.C.			
Ce.			
C.			
M.			
M.			
K.			
Mz.			
Mq.			
V.			
S.			
S.			
A	<u>3272</u>		<u>1409</u>
R.			
Pe.			
G.			
T.D.	<u>3275</u>		

Loc. in Sec. SWNW SE

Geol. _____
 Contr. _____
Sidey

Pool Atherton

COMPLETE		

Lse.

No.

Date Comm. 5-18-55 JUN 22 1955
8" @ 220 5 1/2" @ 3274/150 DD 3276
FU 800' oil 1 hr. FU 2000' oil 12 hr.
Comp. 25 bopd

Sec.

T.

R.