


Russell

Form 51-5M-5-34-Palace

Map No. **KANSAS** Sec. 28 Twp. 13 R. 14W

Well No. 2 Ehrlich Farm  
Empire Oil Company

NORTH

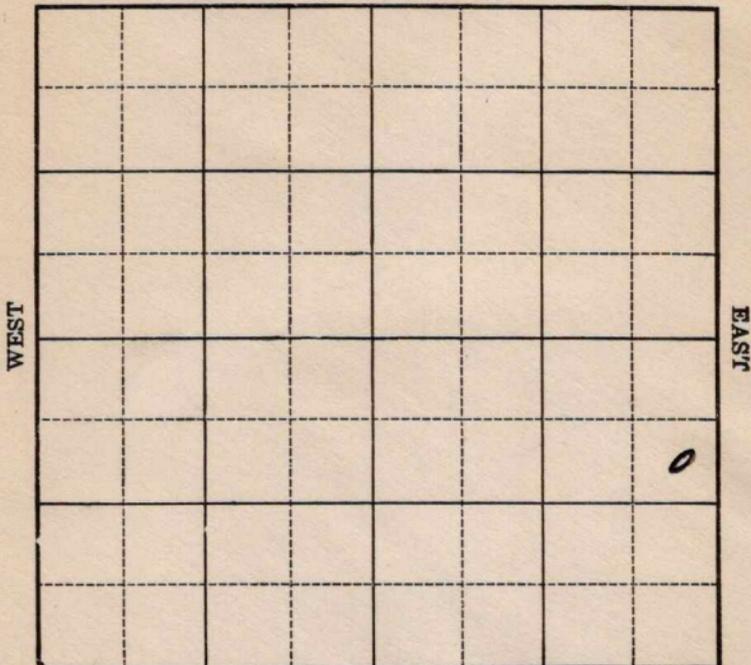

SOUTH

Location \_\_\_\_\_

Drilling Remarks \_\_\_\_\_  
\_\_\_\_\_  
\_\_\_\_\_  
Rig Up \_\_\_\_\_

Drilling Remarks \_\_\_\_\_  
\_\_\_\_\_  
\_\_\_\_\_  
**RECORD**

Cased \_\_\_\_\_ in. \_\_\_\_\_ ft.

Sand \_\_\_\_\_

Gas \_\_\_\_\_

Oil \_\_\_\_\_

Total Depth \_\_\_\_\_

**PRODUCTION**

1st 24 hrs. Nat. \_\_\_\_\_

1st 24 hrs. after shot \_\_\_\_\_

Gas \_\_\_\_\_ cu. ft.

Dry Hole \_\_\_\_\_


Abandoned \_\_\_\_\_

Russell

Map No. \_\_\_\_\_ Sec. 28 Twp. 13 R. 14W

Well No. # 2 Ehrlich Farm \_\_\_\_\_  
Empire Oil Company \_\_\_\_\_

990 Ft. from N. Line  
\_\_\_\_ Ft. from S. Line  
330 Ft. from E. Line  
\_\_\_\_ Ft. from W. Line

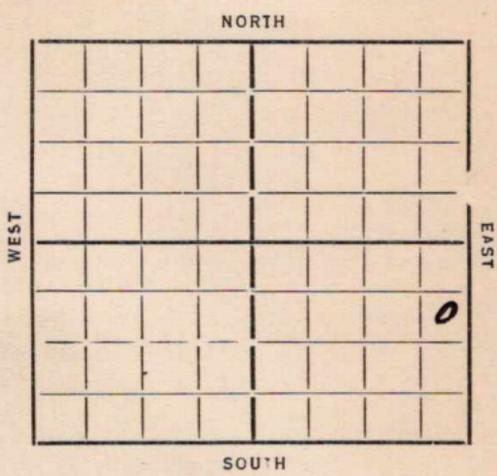

Date	REPORT
1935	
2/13	Location
2/21	Ponds
2/28	Material
3/7	Rig
3/14	Spud
3/21	dy 425 20" 21 15" 368
3/28	" 885 12" 571
4/4	" 1365 12" 882
4/11	" 2125
4/18	Gas 2185-90 Run 10" 2355 T1)
4/26	sg 2385 10" 2451
	Gas 2460-63 dy 2900
5/2	S.O. 2965-75 Oswald 3000
	S.O. 3045 Inw 3060-66 0
	3090-91 8" 3091 1200' oil
5/9	Log
5/16	8" 3195 T1 3250 WOC.
5/23	Sil 3272 Pay 3275
	T1 3279 936" liner
	2700 oil acidize
5/29	1000 acid Pump 1220 Bbls
	20 hrs. (OVER)

731279

6/5 Silicious 3272

Oil 3275

T. 3279

1000 acid

1460 Bble.

COMPLETED

Map No. 7W Sec. 28 Twp. 13 R. 14W

Well No. 2-Ehrlich

Empire oil

Company

Contractor

**FIRST REPORTS**

**SECTION PLAT**

990 Ft. from N. Line

..... Ft. from S. Line

330 Ft. from E. Line

..... Ft. from W. Line

			o

**KANSAS**

Location

Rig up.....

Drilling and Remarks:

**RECORD**

Cased.....in., .....ft.

Sand.....

Gas.....

Oil.....

Total Depth.....

**PRODUCTION**

1st 24 hrs. Nat.....

1st 24 hrs. after shot.....

Gas.....Cu. Ft.

Dry Hole.....

Abandoned.....

Date

2-13-35 192.....

**ORVAL MANNSCHRECK**

Scout

Map No. 72 Sec. 28 Twp. 13 R. 14W

Well No. 2-Ehrlich

Empire oil Company

Contractor

COMPLETED

SECTION PLAT

990 Ft. from N. Line

..... Ft. from S. Line

330 Ft. from E. Line

..... Ft. from W. Line

			0

Location.....

Rig up.....

Drilling and Remarks;

1000 and

1460 bbls

RECORD

Cased..... in., ..... ft.

Sand siliceous 3272

Gas.....

Oil 3275

Total Depth 3279

PRODUCTION

1st 24 hrs. Nat.....

1st 24 hrs. after shot.....

Gas..... Cu. Ft.

Dry Hole.....

Abandoned.....

ORVAL MANNSCHRECK

Date

6-5-35 192.....

Scout