


Section.....28.....Township.....13.....Range 14 W.....

Well Number.....8 Erhlick.....

Company.....Empire.....

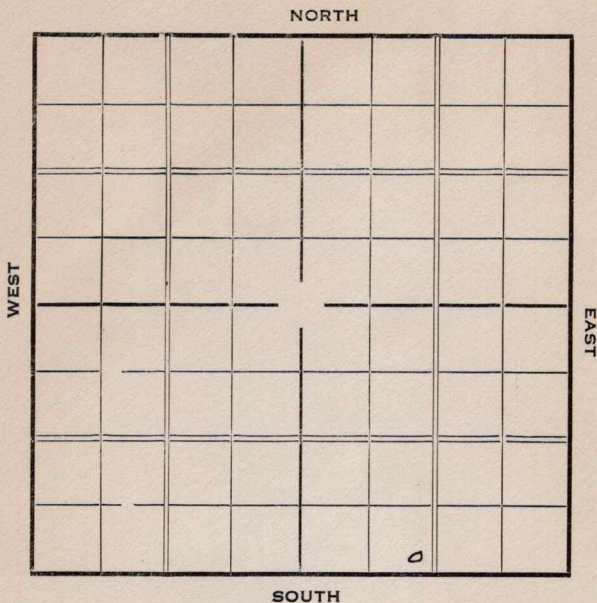

Sec. 28 Twp. 13 R. 14-W

Well No. #8 Ehrlick Farm

Empire Company


_____ Ft. from N. Line

330 Ft. from S. Line

_____ Ft. from E. Line

990 Ft. from W. Line

Elev. 1865

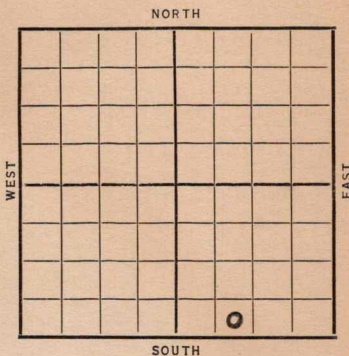

| Date | REPORT |
|------|--|
| 1937 | |
| 1/13 | Rig. |
| 1/21 | Rigging up. |
| 1/28 | " " |
| 2/4 | Run 10" @ 860 |
| 2/11 | Drlg. 1025 |
| 2/19 | Drlg. 2370' |
| 2/26 | Drlg. 3155'. |
| 3/4 | 7" @ 3263'. RUST |
| 3/11 | Sil 3279'. T.D. 3307'. 3000 acid No Test. |
| 3/18 | Pump 550' oil 16% water 14 hrs. |
| 3/24 | Sil. 3279'. T. D. 3307'. 3000 acid. Potential 749 oil, 30% water. |
| | COMPLETED |

Map No. 72 Sec. 28 Twp. 13 R. 14W

Well No. 8 Eureka

Empire Company

Contractor

SECTION PLAT

| | | | |
|--|--|--|---|
| | | | |
| | | | |
| | | | |
| | | | 0 |

_____ Ft. from N. Line

330 Ft. from S. Line

_____ Ft. from E. Line

990 Ft. from W. Line

FIRST REPORT

Location _____

Rig up _____

Drilling and Remarks:

Rig

RECORD

Cased _____ in., _____ ft.

Sand _____

Gas _____

Oil _____

Total Depth _____

PRODUCTION

1st 24 hrs. Nat. _____

1st 24 hrs. after shot _____

Gas _____ Cu. Ft.

Dry Hole _____

Abandoned _____

Date

JAN 13 1937 19

S. J. LEWIS Scout

Map No. 72 Sec. 28 Twp. 13 R. 14W

Well No. 8 Ehrlich

Empire Company

Contractor

SECTION PLAT

| | | | |
|--|--|--|--|
| | | | |
| | | | |
| | | | |
| | | | |

_____ Ft. from N. Line

330 Ft. from S. Line

_____ Ft. from E. Line

990 Ft. from W. Line

COMPLETED

Location _____

Rig up _____

Drilling and Remarks:

*Sil 8279
3000 acid
Potential
749 - 30%
water*

RECORD

Cased _____ in., _____ ft.

Sand _____

Gas _____

Oil _____

Total Depth 3307

PRODUCTION

1st 24 hrs. Nat. _____

1st 24 hrs. after shot _____

Gas _____ Cu. Ft.

Dry Hole _____

Abandoned _____

Date

MAR 24 1937 19

S. J. LEWIS Scout