


Ellis

KANSAS

SECTION 27 TOWNSHIP 13 RANGE 20W

WELL NO. #3 Waldschmidt

COMPANY Imperial Oil Co.

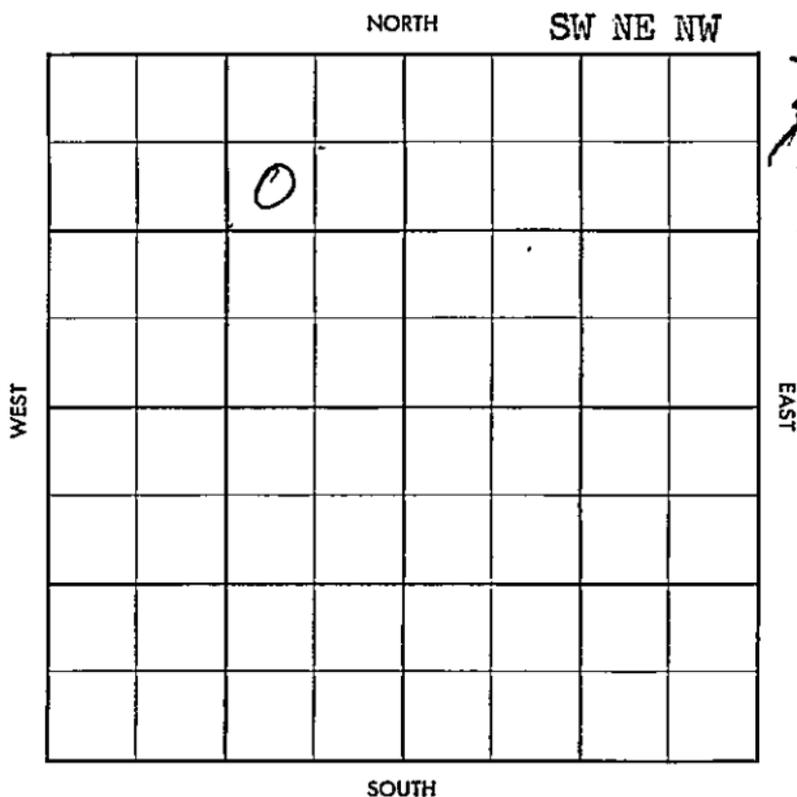

County Elvis Elev. 2210 RB
 Sec. 27 Twp. 13 Rge. 20W
 Company Imperial Oil Co.
 Farm Name Waldschmidt No. 3

TOPS	DEPTH	LOG	DATUM	Loc. in Sec.
Anb.	1520			SW NE NW
TP.				
H.	3438			
Tr.				
Dg.				
Bl.				
L.	3478			Geol.
K.C.				Contr.
B.K.C.				
Ce.	3826			Co. Tools
C.				
M.				Pool
M.				Pleasant
K.				
Mz.				
Mo.				
V.				
S.				
S.				
A	3826	3826		AUG 14 57
R.				COMPLETE
PE.				
G.				
T.D.	3830			

Date Comm. 6-28-57

8" @ 230/175, Drlg. 2495 JUL 10 57 ; H/L 3438
 Lsg 3478 DST 3472 - 8/2 hrs rec
 75' MW BHP 75 DST 3554 - 63
 2 hrs rec 130' wtg BHP 1190
 DST 3567 - 72 up 2 hrs 1835
 gas rec 60' HOCM + 90' MCB +
 150' wtg BHP 1005 DST 3583 - 95
 up 2 hrs rec 225' wtg BHP 1135
 3619 ^{1127 5/11} Alb DST 3628 - 40

of 1 hr see 15' Md BHP 35 DST
 3652-63 of 2 hrs see 280'
 wtr + 550 BHP 1155 DST 3677
 ← 85 of 2 hrs see 925 gas
 see 60' MCO + 35' oil BHP 1135
 DST 3704-32 of 2 hrs 810' gas
 see 65' OCM + 30' MCO + 30' oil
 BHP 360 ~~360~~ RTD 3826 RTD
 3830 Log 5 1/2 @ 3828 WOCT
 3826 ~~3826~~ 1 co 3830 RTD \$ 2 1/2
 Boph no/w 4 hrs \$ 3.36
 Boph no/w 24 hrs ~~1/2~~ \$
 11 Boph no/w 12 hrs Pop
 JUL 31 '57
 Ph P. 265 Bopd no/wtr

County Ellis Elev. _____
 Sec. 27 Twp. 13 Rgs. 20W
 Company Imperial Oil Co.
 Farm Name Waldschmidt No. 3

TOPS	DEPTH	LOG	DATUM
Anh.	<u>1520</u>		
Tr.			
H.			
Tr.			
Dg.			
Bl.			
L.			
K.C.			
B.K.C.			
Ce.			
C.			
M.			
M.			
K.			
Mz.			
Ma.			
V.			
S.			
S.			
A.			
R.			
PE.			
G.			
T.D.			

Loc. in Sec. _____
SW NE NW
 Geol. _____
 Contr. _____
 Co. Tools _____
 Pngl. _____
Pleasant
 FIRST REPORT
 JUL 3 57

Date Comm. 6-28-57
8" @ 230/175, Drlg. 2495

[Handwritten signature]

Co.
Lse.
No.
Sec.
T.
R.