


Section 27 Township 13 Range 20-W


Well No. #1 Giebler

Company Darby Petroleum
(Wildcat)

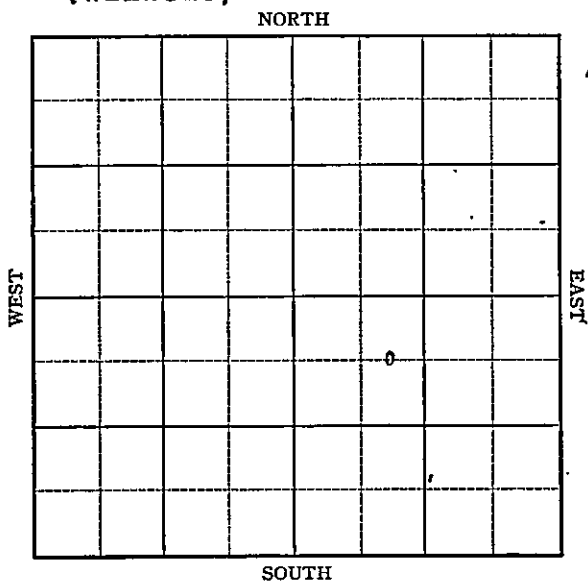

KANSASSec. 27 Twp. 13 R. 20-WWell No. #1 Giebler FarmDarby Petroleum Company
(Wildcat) Ft. from N. Line1980' Ft. from S. Line1650' Ft. from E. Line Ft. from W. Line

Elev. 2204

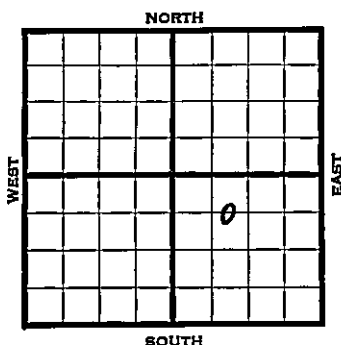

1941

REPORT

7/30

Rotary

8/15

Drlg. 3490'

8/21

Topeka 3210' Lans. 3482'

Arb. 3832' T.D. 3848'

5" - 3833' RUST.

8/27

Arb. 3832'

5" - 3833'

T.D. 3899'

Water.

ABANDONED

KANSAS

Map No. 70 Sec. 27 Twp. 13 R. 20WWell No. 1 Giebler

Darby Petroleum

Company

Contractor

FIRST REPORT

SECTION PLAT

C E L NW SE

Ft. from N. Line

1980 Ft. from S. Line1650 Ft. from E. Line

Ft. from W. Line

		o	

WILDCA T

Location

Rig up

Drilling and Remarks:

Rotary

RECORD

Cased _____ in., _____ ft.

Sand _____

Gas _____

Oil _____

Total Depth _____

PRODUCTION

1st 24 hrs. Nat. _____

1st 24 hrs. after shot _____

Gas _____ Cu. Ft.

Dry Hole _____

Abandoned _____

Date

JUL 30 1941 19

S. J. LEWIS Scout

Map No. 70 Sec. 27 Twp. 13 R. 20WWell No. 1 GieblerDarby Petroleum CompanyABANDONED Contractor

C E L NW SE

SECTION PLAT

 Ft. from N. Line1980 Ft. from S. Line1650 Ft. from E. Line Ft. from W. Line

WILDCAT

Location Rig up

Drilling and Remarks:

*Cor 83832**5" 83833**Water*

RECORD

Cased in., ft.Sand Gas Oil Total Depth 3279

PRODUCTION

1st 24 hrs. Nat. 1st 24 hrs. after shot Gas Cu. Ft.Dry Hole Abandoned

Date

AUG 27 1941 19 S. J. LEWIS Scout