


FORM 51

Ellis

KANSAS

Section 27 Township 13 Range 20WWell No. 2 GieblerCompany Imperial Petroleum Company

NORTH

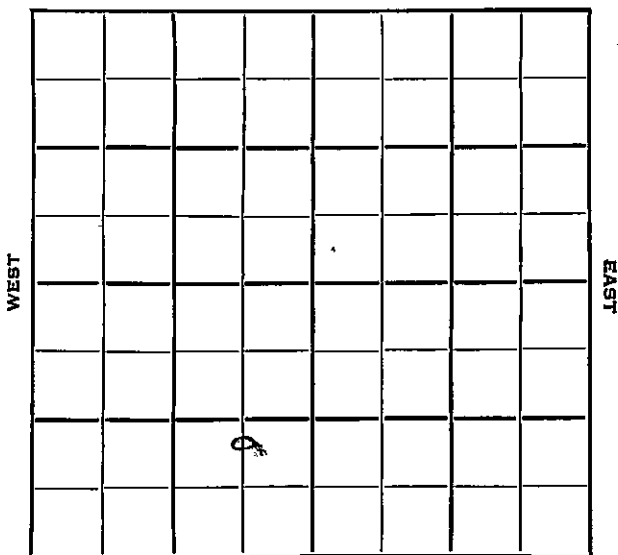

SOUTH

Ellis

KANSAS

Sec. 27 Twp. 13 R. 20W

Well No. 2 Giebler Farm

Imperial Petroleum Company

Imperial Contr. Contractor


Ft. from N. Line

990 Ft. from S. Line

660 Ft. from E. Line

Ft. from W. Line

C N L SE SW

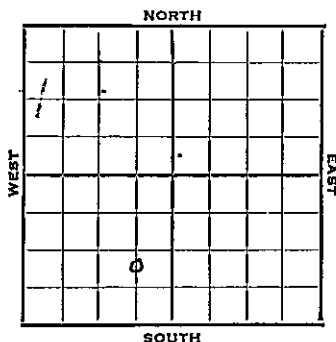

1953 Elev. 2237 REPORT

1/7 Location
1/8 Location
1/22 8" @ 228 Anhy 1542' Top 3209'
DST 3419-37, 1 hr, 1000' O & GCSW
1230# Heeb 3465' Tor. 3486'
KC 3503'
DST 3580-92, 1/2 hr, 600' SW 1230#
Drlg. 3675'
1/29 B KC 3763
DST 3810-24, 1 hr., 35' mud, 0#
Arb. 3830
DST 3831-38, 1 1/2 hrs., 55' OCM,
730#
RTD 3843
DST 3838-43, 285' GCO, 560' gas,
990#
5" @ 3837
CO 3843, blew tools up hole
CO S/2 1/2 BOPH 9 hrs.
2/5 500 A S/9 BOPH 3 hrs. 1500 A
S/12 BOPH POP
2/12 NR

OVER

1953

2/18 Spudding Date 1/7/53
Oil Well TD 3843
8" @ 228 Anhy 1542 Top 3209 DST
3419-37 1 hr. Rec. 1000' o & gcsw
1230# Heeb. 3465 Tor. 3486
KC 3503 DST 3580-92 open $\frac{1}{2}$ hr.
Rec. 600' sw 1230# B KC 3763 DST
3810-24 open 1 hr. Rec. 35' mud
Off Arb. 3830 DST 3831-38
op $1\frac{1}{2}$ hr. Rec. 55' OCM 730#
TD 3843 DST 3838-43 open 1 hr.
Rec. 285' gco 560' gas 990#
5" @ 3827 CO to 3843 S/2 $\frac{1}{2}$ boph 9 hr.
500 A S/9 boph 3 hr. 1500 A
S/ 12 boph Comp. 306 bopd

COMPLETED

County Ellis State KansasSec. 27 (Blk.) 13 (Sur.) 20W Map No.Operator Imperial Pet.Well No. 2 Farm GieblerElev. 2237 Location C N L SE SW

FIRST REPORT

990 Ft. From S Line SW660 Ft. From E Line Quarter1st. Report JAN 7 1953

Completion

Remarks


Imperial - Contr.

Spudding Date

Drilg. Data

Location

J. G. McGEHEE

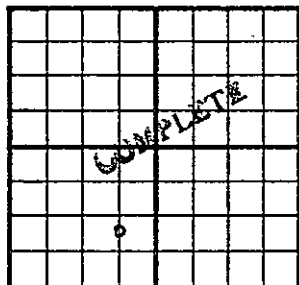County Ellis State KANSASSec. 27 (Blk.
Twp.) 13 (Sur.
Rgs.) 20W Map No.Operator Imperial Pet.Well No. 2 Farm GieblerElev. 2237 Location C N L SE SW990 Ft. From S Line SW660 Ft. From E Line Quarter

1st. Report

Completion FEB 18 1953

Remarks

Imperial - Contr.Spudding Date 1-7-53Drilg. Data Oil well TD 38438" @ 228 Anhy 1542 Top. 3209DST 3419-37 open 1 hr. Rec. 1000' o &gcs w 1230# Heeb. 3465 Tor. 3486KC 3503 DST 3580-92 open 1/2 hr. Rec.600' sw 1230# B KC 3763 DST 3810-24open 1 hr. Rec. 35' mud O# Arb. 3830DST 3831-38 open 1 1/2 hr. Rec. 55' ocm730# TD 3843 DST 3838-43 open 1 hr.Rec. 285' gco 560' gas 990#5" @ 3837 CO to 3843 S/ 2 1/2 boph 9 hr.500 A S/ 9 boph 3 hr. 1500 AS/ 12 boph Comp. 306 bopd

J. G. McGEHEE