

SEC.	TWP.	R.
27	13	20W ✓

WELL NO.

#3 Giebler "B"

FARM

COMPANY

C R A & N A C C

CONTRACTOR

C R A

NW Pleasant Pool


NORTH

_____ Ft. from N. Line

990 _____ Ft. from S. Line

_____ Ft. from E. Line

990 _____ Ft. from W. Line

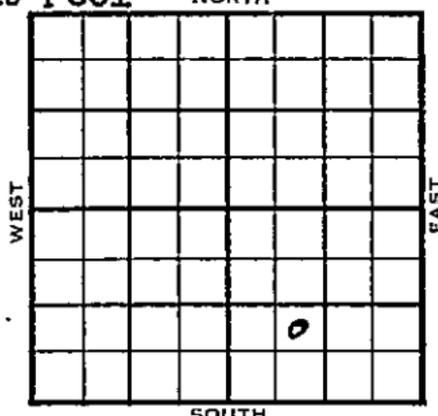

NE SW SE

ELEVATION

REPORT

1953

2205'

11/18

C & P

1954

1/27

Spud 11-18-53 Oil well TD 3850'
 8-5/8" @ 255 Heeb 3441 Tor 3462'
 Lans. 3483 Gorham 3804 Arb. 3809'
 DST 3795-3850 open 1 hr rec 2000'
 gassy oil, 160' gas, 960#
 5" @ 3850 TD 3850 CO to 3845
 24/3826-32 1/2 BO 500 mud-acid
 500 A S/129 BF 6 hr. S/140 BO 9 hr.
 P/93 BF 8 hr.
 Comp. 395 BOPD 13% wtr.

COMPLETED

