
DX 78-1

Ellis KANSAS

Section 8 Township 14 Range 19W

Well No. 1 Riedel

Company Frontier Oil

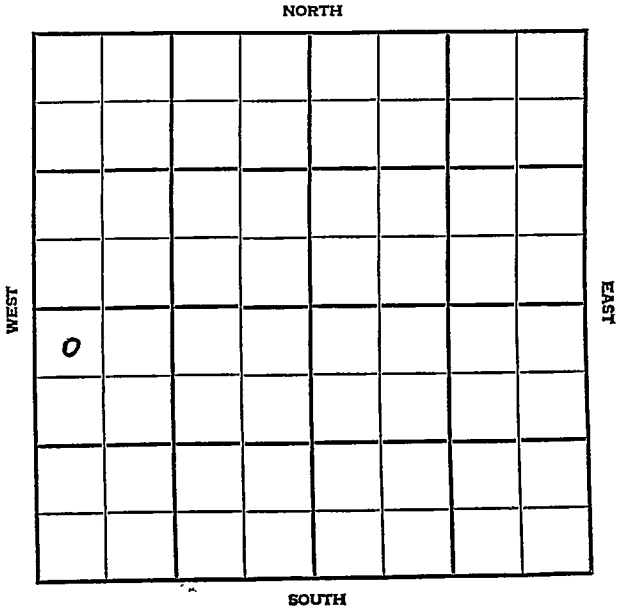

Ellis KANSAS

SEC.	TWP.	R.
8	14	19W

WELL NO

#1 Riedel FARM

COMPANY

Frontier Oil

CONTRACTOR

Lebon


Irvin Pool

330 Ft. from N. Line

_____ Ft. from S. Line

_____ Ft. from E. Line

330 Ft. from W. Line

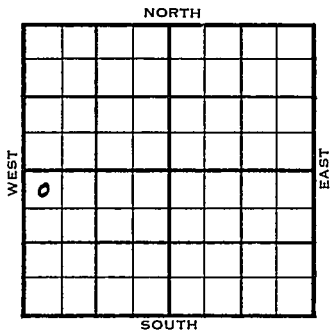

NW NW SW
Stanolind DHM & FO

1955	ELEVATION 2213' REPORT
3/9	Spud 3-5-55 8" @ 162' Drlg. 1365'
3/23	Spud 3-5-55, D&A, TD 3894, 8" @ 162, Anhy 1485, Heeb 3474, Lans 3517, Arb 3875, TD 3894, D&A

ABANDONED

DX-78

FORM 275 FOR SALE BY KANSAS BLUE PRINT CO


County Ellis State Kansas

Sec. 8 (Blk. Twp.) 14 (Sur. Rge.) 19W Map No.

Operator Frontier Oil

Well No. 1 Farm Riedel

Elev. Location NW NW SW

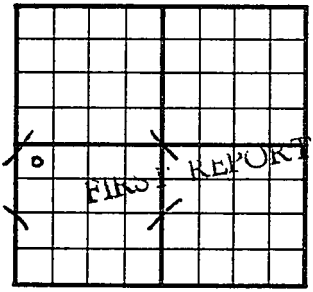

330 Ft. From N Line SW

330 Ft. From W Line Quarter

1st. Report MAR 9 1955

Completion

Remarks Stanolind DHM & FO
Lebon - Contr.

Spudding Date 3-5-55

Drlg. Data Irvin Pool

8" @ 162 drlg. 1365

FABEN GILSTRAP

FORM 275 FOR SALE BY KANSAS BLUE PRINT CO.


County Ellis State Kansas

Sec. 8 (Blk. Twp.) 14 (Sur. Rge.) 19W Map No.

Operator Frontier Oil

Well No. 1 Farm Riedel

Elev. 2213 Location NW NW SW

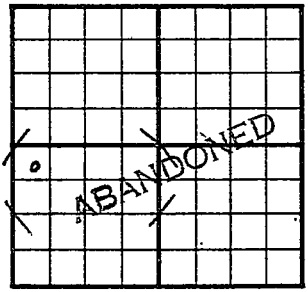

330 Ft. From N Line SW

330 Ft. From W Line Quarter

1st. Report

Completion MAR 2 3 1955

Remarks Irvin Pool

Lebon - Contr.

Spudding Date 3-5-55

Drlg. Data D & A TD 3894

8" @ 162 Anhy 1485 Heeb. 3474

Lans. 3517 Arb. 3875 TD 3894

D & A

FABEN GILSTRAP