


Section 8 Township 14 Range 19W


Well No. #2 Reidel

Company Lewis Drlg.

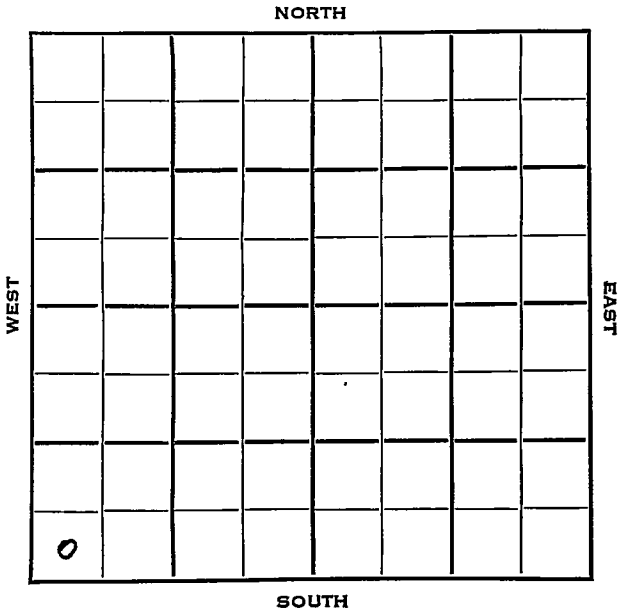

Sec. 8 Twp. 14 R. 19 WWell No. # 2 Reidel FarmLewis Drlg. CompanyLewis Drlg. ContractorS. Irvin Pool Ft. from N. Line330 Ft. from S. Line Ft. from E. Line330 Ft. from W. Line

SW SW SW

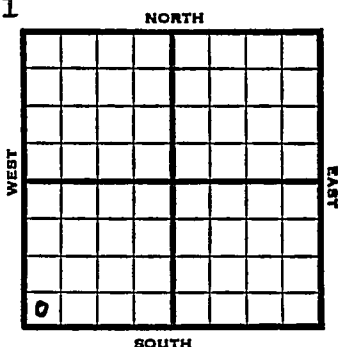

1953

Elev. 2212' REPORT

9/2

Spud 8-29-53
8" @ 150 WOG

9/9

NR

9/16

Spud 8-29-53 D & A TD 3884
 8" @ 150 Heeb 3475 KC 3518
 DST 3556-70 open $\frac{1}{2}$ hr rec 20' mud
 Cong 3802 Arb. 3878
 TD 3884' D & A

ABANDONED

County **Ellis** State **Kansas**

Sec. 8 (Blk.) 14 (Sur.) 19W Map No.

Operator **Lewis Drlg.**

Well No. **2** Farm **Reidel**

Elev.	Location	SW	SE	SW	SE
-------	----------	----	----	----	----

FIRST REPORT

330 Ft. From S Line SW

330	Ft. From	W	Line	Quarter
-----	----------	---	------	---------

1st. Report SEP 2 1953

Completion

Remarks

Lewis Drlg. - Contr.

Spudding Date **8-29-53**

Drbg. Data

8th @ 150 WOC

J. G. McGEHEE

County Ellis State Kansas

Sec.	8	(Blk. Twp.)	14	(Sur. Rge.)	19W	Map No.
------	---	----------------	----	----------------	-----	---------

Operator Lewis Drlg.

Well No. 2 Farm Reidel

Elev.	2212	Location	SW SW SW
-------	------	----------	----------

ABANDONED

330 Ft. From S Line SW

330 Ft. From W Line Quarter

1st. Report

SEP 16 1952

Remarks S. Irvin Pool

Lewis Drlg. - Contr.

Spudding Date 8-29-53

Drig. Data D & A TD 3884

8" @ 150 Heeb. 3475 KC 3518

DST 3556-70 open $\frac{1}{2}$ hr. Rec. 20' mud

Cong. 3802 Arb. 3878 TD 3884

D & A

J. G. McGEHEE