


Section 23 Township 34 Range 3E

Well No. #1 Ark River

Company Aylward Drlg.

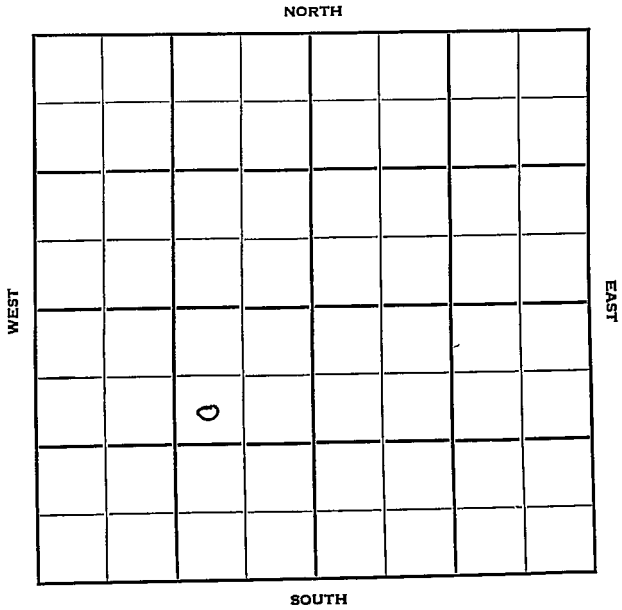

Cowley

Sec. 23 Twp. 34 R. 3E

Well No. #1 Ark-River Farm

Aylward Drlg. Company

Contractor


990 Ft. from N. Line

Ft. from S. Line

990 Ft. from E. Line

Ft. from W. Line

SW 1/4 SW NE SW

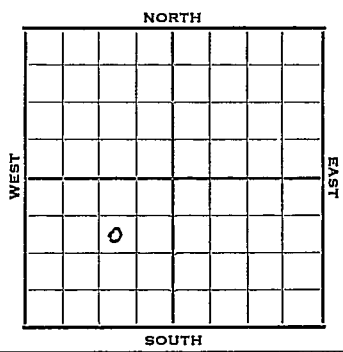

1952 Elev. 1078' REPORT

10/29 8" @ 98'  
 Layton 2574', KC 2768', Bart 3273',  
 Bart. sd. 3287'  
 TD 3294'  
 5" @ 3287'  
 DD 3302'

12/30 D & A TD 3309' 8" @ 98  
 Layton 2574' KC 2768' Bart 3273'  
 Bart sd 3287' TD 3294' 5" @ 3287  
 DD 3302' DD 3309' PB 3295'  
 21/3280-86 Hydro. P/3 BOPD  
 D & A

**ABANDONED**



