


SECTION 9 TOWNSHIP 14 RANGE 19W

WELL NO. #1 Dechant

COMPANY Peel-Hardman

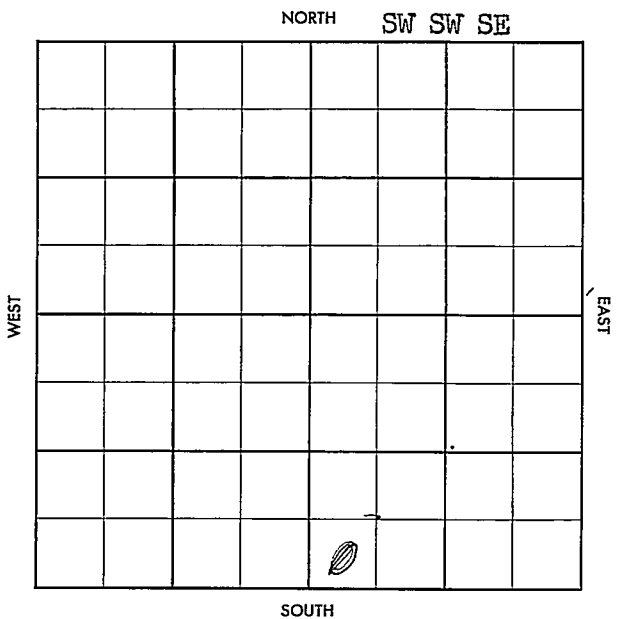

County Ellis Elev. 2203 DF
 Sec. 9 Twp. 14 Rge. 19W
 Company Peel-Hardman
 FarmName Dechant No. 1

Co.

TOPS	DEPTH	LOG	DATUM
Anh.			
Tp.			
H.	3462		
Tr.			
Dg.			
Bl.			
L.	3508		
K.C.			
B.K.C.			
Ce.			
C. <u>cherty</u>	3798		
M.			
M.			
K.			
Mz.			
Ma.			
V.			
S.			
S.			
A.			
R.			
Pe.			
G.			
T.D.	3851		

Loc. in Sec. SW SW SE
 Geol. _____
 Contr. Peel Bros.
 Pool Kraus

Lse.

ABANDONED

	MAY 8 '57	

No.

Date Comm. M I R T MAY 8 '57 4-28-57 858
217/200 DST 3526-68 1hr 40'
WM BHP 1045 DST 3688-3725
45" rec 20' Md BHP 1125

Sec.

T

DEA

R.