


Section 28 Township 13 Range 20W

Well No. #1 A. Herman

Company Continental Oil

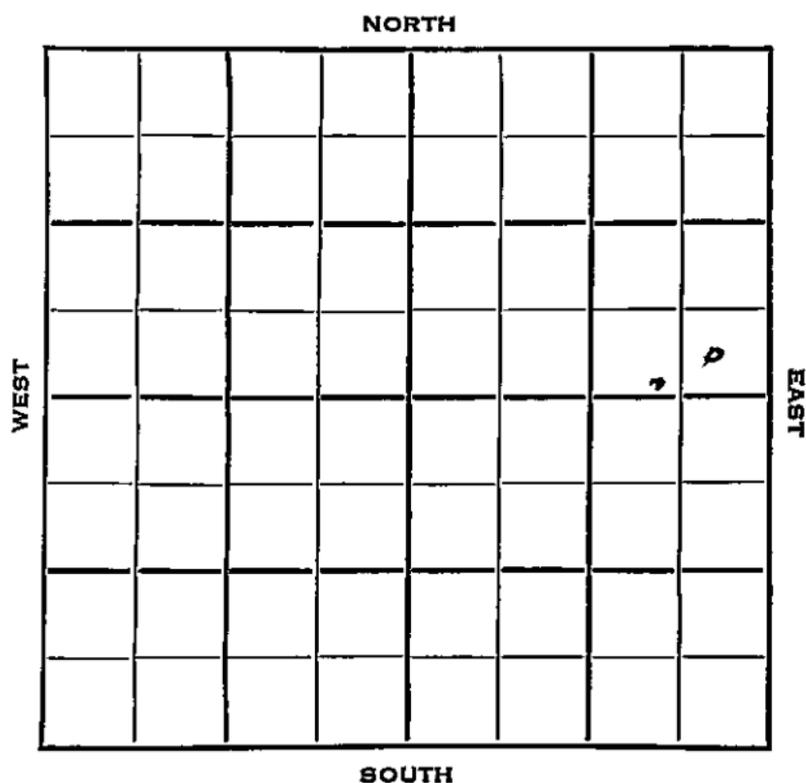

Ellis

KANSAS

SEC. 28	TWP. 13	R. 20W ✓
------------	------------	-------------

WELL NO. #1 A. Herman FARM

COMPANY Continental Oil

CONTRACTOR Lohman & Johnson

NW Pleasant Pool

NORTH

\_\_\_\_\_ Ft. from N. Line

330 \_\_\_\_\_ Ft. from S. Line

330 \_\_\_\_\_ Ft. from E. Line

\_\_\_\_\_ Ft. from W. Line


WEST

EAST

SOUTH

SE SE NE

1954	ELEVATION 22220'	REPORT
------	---------------------	--------

Arb Test.

4/7 Spud 4-1-54  
9" @ 258'  
Anhy 1538'  
Drlg 3235'

4/14 Spud 4-1-54  
D & A  
TD 3900'  
9" @ 258'  
Anhy 1538',  
DST 3253'-64' opn 1 1/4 hr, rec 110' Muddy  
SW 900# Top 3209', Heeb 3465' Tor 3485'  
Lans 3504', Cong 3803', Arb 3873'  
DST 3872'-78' opn 1 hr, rec 25' Mud 630'  
DST 3876'-83' opn 1 hr, rec 80' Muddy  
SW 0#  
TD 3903'  
Schlumberger Tops: Top 3212', Heeb 3460'  
Tor 3480', Lans 3499', Cong 3796' Arb  
3870'  
TD 3900'  
D & A

**ABANDONED**



