


Section 23 Township 34 Range 3 **KANSAS** W

Well No. # 1 Bivens

Company Absher & Booth

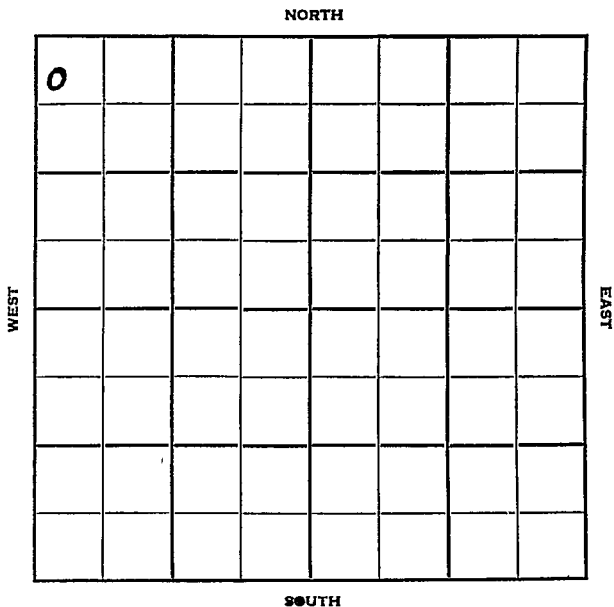

Cowley

KANSAS

Sec. 23 Twp. 34 R. 3E

Well No. #1 Bivens Farm

Absher & Booth Company

Contractor


459 Ft. from N. Line

Ft. from S. Line

Ft. from E. Line

237 Ft. from W. Line

NW NW NW

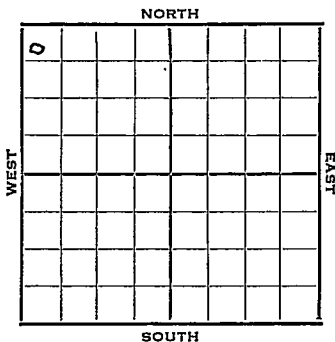

1952

Elev. 1077' REPORT

9/10

Spud 9-7-52
8" @ 91' WOC

12/3

Spud 9-7-52
Oil Well
TD 3274'
8" @ 91
Bart: 3263
TD 3274
5" @ 3264
F/50 bopd
Comp. BHB 1684 bopd

COMPLETED

County Cowley State Kansas

Sec. 23 (Blk. 34 (Sur. 3E (Twp.) 3E Map No.

Operator Absher & Booth

Well No. 1 Farm Bivens

Elev. _____ Location NW NW NW

0							

459 Ft. From N Line NW

237 Ft. From W Line Quarter

Ist. Report SEP 10 1952

Completion _____

Remarks _____

Spudding Date 9-7-52

Drlg. Data _____

8" @ 91 WOC

J. G. McGEHEE

County Cowley State Kansas

Sec. 23 (Blk. 34 (Sur. 3E (Twp. 34 (Rge. 3E Map No.

Operator Absher & Booth

Well No. 1 Farm Bivens

Elev. 1077 Location NW NW NW

0					

459 Ft. From N Line NW

237 Ft. From W Line Quarter

Ist. Report

Completion DEC 3 1952

Remarks

Spudding Date 9-7-52

Drig. Data Oil well TD 3274

8" @ 91 Bart. 3263 TD 3274

5" @ 3264 F/ 50 bopd

Comp. BHB 1684 bopd