


Section 9 Township 14 Range 19 W

Well No. # 1 Vonfeldt

Company H. G. Kaiser

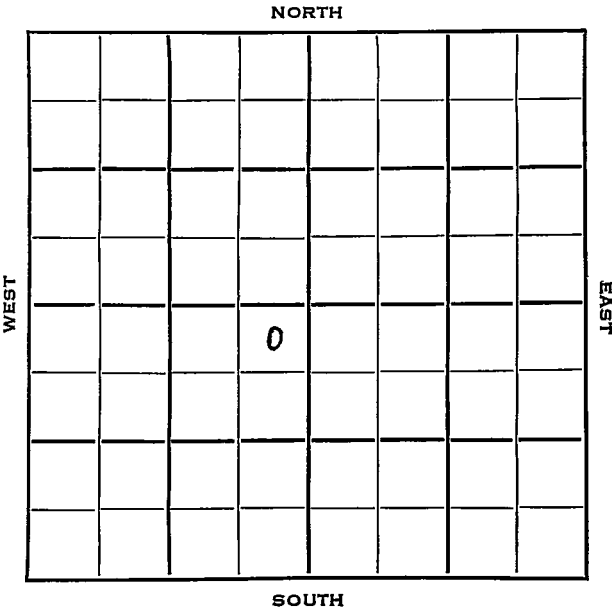

Ellis

KANSAS

SEC. 9	TWP. 14	R. 19W ✓
-----------	------------	-------------

WELL NO.

#1 Vonfeldt

FARM

COMPANY

H.G. Kaiser

CONTRACTOR


Wildcat

330 Ft. from N. Line

Ft. from S. Line

330 Ft. from E. Line

Ft. from W. Line

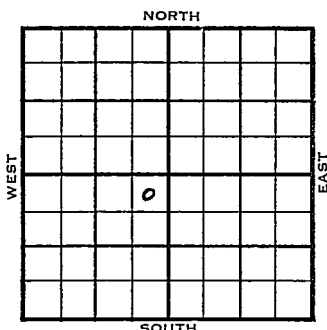

NE NE SW

Sunray - DHM

	ELEVATION	REPORT
1953	2225'	

11/18 Spud 11-16-53
8" @ 198'

WOC

12/2 Spud 11-16-53

D&A

TD 3898'

8" @ 198'

Heeb 3486', Tor 3510', Lans 3529

DST 3524-80', opn 1 hr., rec. 120'

wtry mud, 1080#

DST 3586-3615', opn 1 hr., rec. 160'

wtry mud, 1145#

Cong. 3820', Arb. 3880'

TD 3898'

Simp. 3850'

D&A

ABANDONED

County Ellis State Kansas

Sec. 9 (Blk. Twp.) 14 (Sur. Rge.) 19 Map No.

Operator H. E. Kaiser

Well No. 1 Farm Vonfeldt

Elev.	Location	NE	NE	SW
-------	----------	----	----	----

[illegible]

330 Ft. From N Line SW

330 Ft. From Line Quarter

1st. Report NOV 18 1953

Completion

Remarks Suprav - DIRM


Spudding Date. 11-16-53

Drig. Data Wildcat

8" @ 198 WOC

J. G. McGEHEE

County Ellis State Kansas
 Sec. 9 (Blk.) 14 (Sur.) 19W Map No.
 Operator H. G. Kaiser
 Well No. 1 Farm Vonfeldt
 Elev. 2225 Location NE NE SW

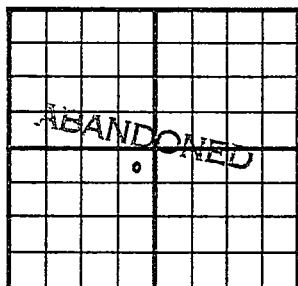

330 Ft. From N Line SW
330 Ft. From E Line Quarter

1st. Report

Completion DEC 2 1953

Remarks Wildcat

Spudding Date 11-16-53

Drlg. Data D & A TD 3898

8" @ 198 Heeb. 3486 Tor. 3510

Lans. 3529 DST 3524-80 open 1 hr.

Rec. 120' wtry mud 1080# DST 3586-

3615 open 1 hr. Rec. 160' wtry mud

1145# Cong. 3820 Arb. 3880 TD 3898

Simp. 3850 D & A