


Section 23 Township 34 Range 3E

Well No. #2 Gross

Company Carl Hines

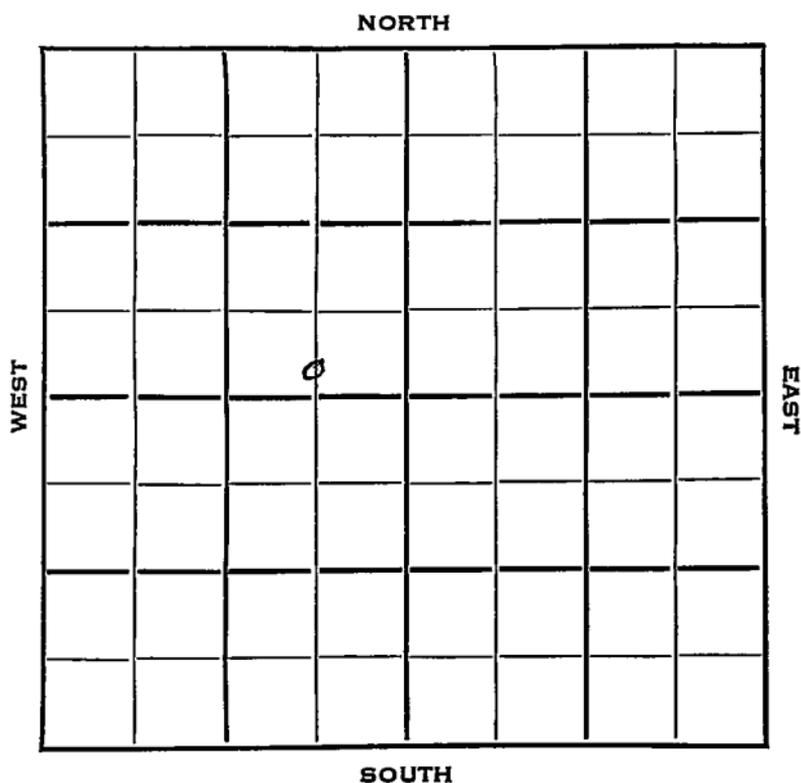

Cowley

Sec. 23 Twp. 34 R. 3E

Well No. #2 Gross Farm

Carl Hines Company

Martin & Cash Contractor


\_\_\_\_\_ Ft. from N. Line

150 Ft. from S. Line

700 Ft. from E. Line

\_\_\_\_\_ Ft. from W. Line

C S L <sup>#</sup> SE NW

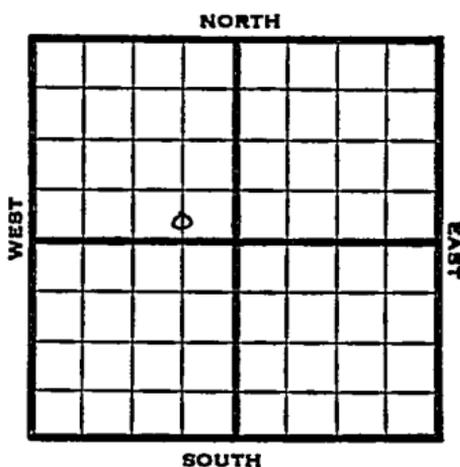

1953

Elv. 1112' REPORT

2/18 8" @ 110 WOC

4/22 Spud 2-26-53

Oil Well

TD 3322'

8" @ 110'

Stal 2180, Layton 2619, KC 2816, Bart 3312,

TD 3320

5" @ 3315'

DD 3322 sd-frac. F/ 26 boph

Comp. 305 bopd.

**COMPLETED**


County Cowley State Kansas

Sec. 23 (Blk. Twp.) 34 (Sur. Rge.) 3E Map No.

Operator Carl Hines

Well No. 2 Farm Gross

Elev. \_\_\_\_\_ Location C S L SE NW

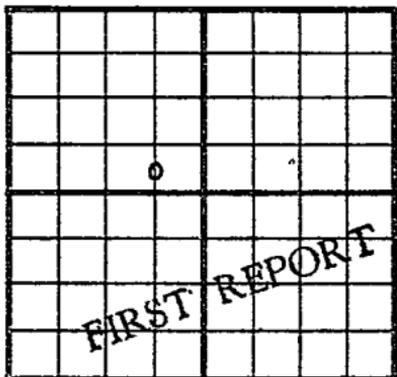

150 Ft. From S Line NW

700 Ft. From E Line Quarter

1st. Report FEB 18 1953

Completion \_\_\_\_\_

Remarks \_\_\_\_\_

Martin & Cash - Contr.

Spudding Date \_\_\_\_\_

Drlg. Data \_\_\_\_\_

8" @ 110 WOC

