


Cowley

Section 23 Township 34 Range 3E

Well No. #3 Gross

Company Aylward Drlg. Company

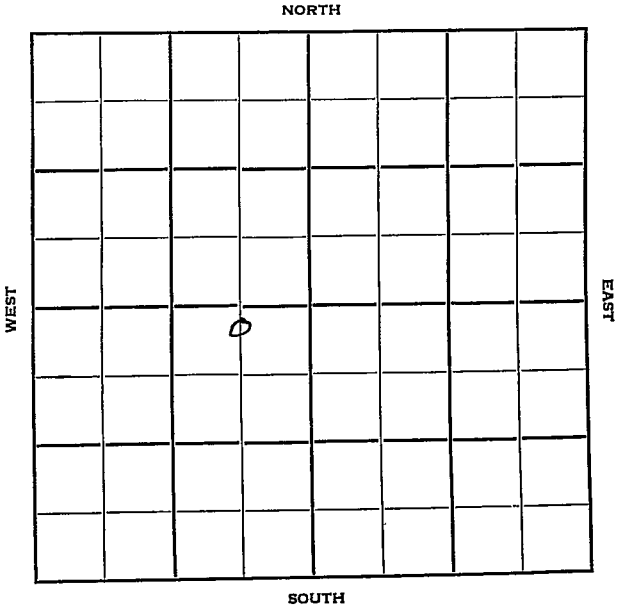

Cowley

KANSAS ✓

Sec. 23 Twp. 34 R. 3E

Well No. #3 Gross Farm

Aylward Drlg. Company Company

Aylward Drlg. - Contr. Contractor


330 Ft. from N. Line

Ft. from S. Line

610 Ft. from E. Line

Ft. from W. Line

C N L NE SW

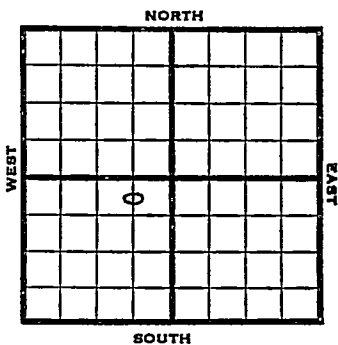

1953

Elev. 1109' REPORT

3/18

R U R

5/6

Spud 3-17-53

Oil Well

TD 3329'

8" @ 82'

Layton 2610, Bart 3315,

TD 3317'

5" @ 3315'

DD 3329'

F/ 30 bo 1/2 hr. Comp 116 bopd.

COMPLETED

County **Cowley** State **Kansas**

Sec. **23** (Blk. Twp.) **34** (Sur. Rge.) **3E** Map No.

Operator **Aylward Drlg.**

Well No. **3** Farm **Gross**

Elev. Location **C N L NE SW**

FIRST REPORT									

330 Ft. From **N** Line **SW**

610 Ft. From **E** Line **Quarter**

Ist. Report **MAR 18 1953**

Completion

Remarks

Aylward Drlg. - Contr.

Spudding Date

Drlg. Data

RUR

County Cowley State KansasSec. 23 (Blk. Twp.) 34 (Sur. Rge.) 3E Map No.Operator Aylward Drlg.Well No. 3 Farm GROSSElev. 1109 Location C N L NE SW

COMPLETE									

330 Ft. From N Line SW610 Ft. From E Line Quarter

1st. Report

Completion MAY 6 1953

Remarks

Aylward Drlg. - Contr.Spudding Date 3-17-53Drlg. Data Oil well TD 33298" @ 82 Layton 2610 Bart. 3315TD 3317 5" @ 3315 DD 3329F/ 30 bo $\frac{1}{2}$ hr. Comp. 116 bopd