

Cowley


FORM 51

KANSAS

Section 23 Township 34 Range 3E

Well No. #3 Gross

Company Carl Hines

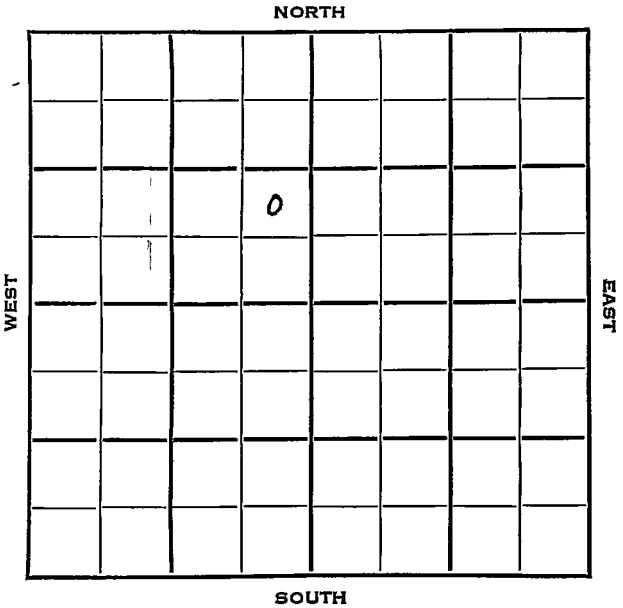

Cowley

KANSAS

SEC.	TWP.	R.
23	34	3 E ✓

WELL NO. # 3 Gross FARM

COMPANY

CONTRACTOR Carl Hines


Martin & Cash

\_\_\_\_\_ Ft. from N. Line

990 \_\_\_\_\_ Ft. from S. Line

330 \_\_\_\_\_ Ft. from E. Line

\_\_\_\_\_ Ft. from W. Line

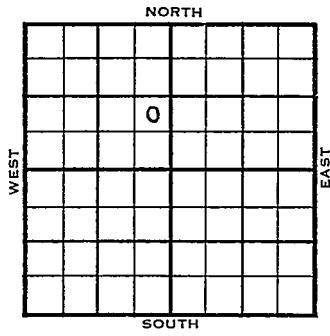

NE SE NW

	ELEVATION	REPORT
1954	1165'	

1/20 Spud 1-13-54  
8" @ 123  
Stal. 2332'  
Drlg. 2555'

2/17 Spud 1-13-54 Oil well TD 3389  
8" @ 123 Stal. 2332 Layton 2677  
KC 2863 Bart. 3379 TD 3385  
5" @ 3381 DD 3389 PB 3387 frac.  
Comp. 514 BOPD

**COMPLETED**



County Cowley State Kansas

Sec. 23 (Blk.) 34 (Sur.) 3E Map No.

Operator Carl Hines

Well No. 3 Farm Gross

Elev. 1165 Location NE SE NW

		0			
<b>COMPLETE</b>					

990 Ft. From S Line NW

330 Ft. From E Line Quarter

Ist. Report

Completion FEB 17 1954

Remarks

Martin & Cash - Contr.

Spudding Date 1-13-54

Drig. Data Oil well TD 3389

8" @ 123 Stal. 2332 Layton 2677

KC 2863 Bart. 3379 TD 3385

5" @ 3381 DD 3389 PB 3387 frac

Comp. 514 bopd

J. G. McGEHEE