Rice


FORM 51

KANSAS

Section 3 Township 18 Range 8W

Well No. #4 Janssen

Company Ash-Mar Drlg.

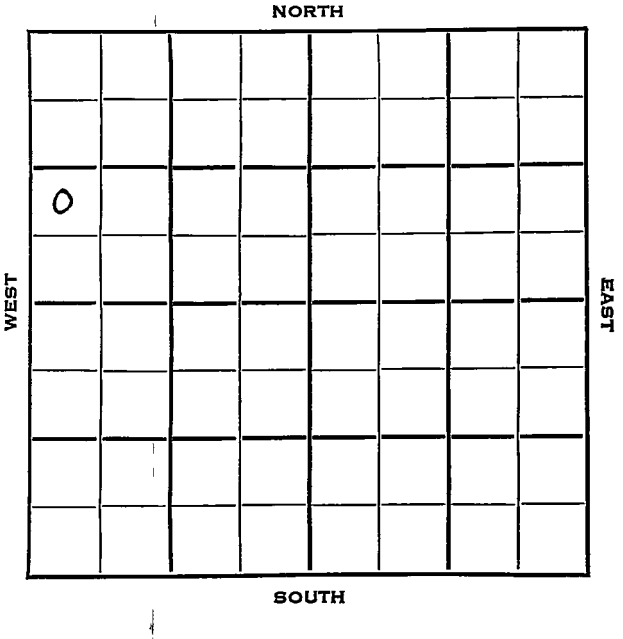

Rice KANSAS

SEC	TWP	R.
3	18	8W

WELL NO.

4 Janssen FARM

COMPANY

Ash-Mar Drlg.

CONTRACTOR

Ash-Mar

Geneseo Pool


_____ Ft. from N. Line

990 Ft. from S. Line

_____ Ft. from E. Line

330 Ft. from W. Line

NW SW NW

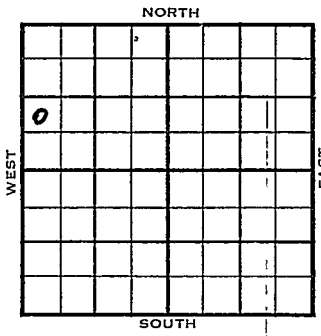

1954 ELEVATION 1773' REPORT

1/6	Spud 1-4-54 8" @ 184', WOC
1/13	Drlg. 2685'
1/20	Br li 2819', Lans 2847', Cong 3218', Arb. 3238' RTD 3282' 5" @ 3282'
1/27	23/3278-82, 50 M- A, 150A 3/4 boph 3 hrs., 500A 7/14 bo 2 hrs.
2/3	NR
2/17	"
3/3	"
3/10	NR
3/17	"
3/24	Spud 1-4-54 Oil Well TD 3282' 8" @ 184' Br lime 2819', Lans 2847', Cpng 3218', Arb. 3238' TD 3282'

DX-78

OVER

(Information Brought Forward)

1954
3/24 5" @ 3282'
23/3278-82
50 mud-acid, 150A
3/4 boph 3 hrs., 500A
S/14 bo 2 hrs.
Comp. 26 bopd 91% wtr.

COMPLETED

FORM 275 FOR SALE BY KANSAS BLUE PRINT CO.


County Rice State Kansas

Sec. 3 (Blk. Twp.) 18 (Sur. Rge.) 8W Map No.

Operator Ash-Mar Drlg.

Well No. 4 Farm Janssen

Elev. Location NW SW NW

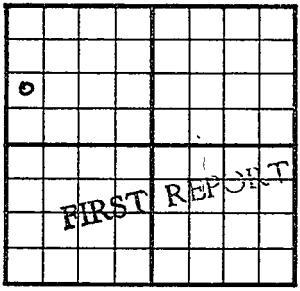

990 Ft. From S Line NW

330 Ft. From W Line Quarter

1st. Report JAN 6 1954

Completion

Remarks

Ash-Mar - Contr.

Spudding Date 1-4-54

Drlg. Data Geneseo Pool

8" @ 184 WOC

J. G. McGEHEE

FORM 275 FOR SALE BY KANSAS BLUE PRINT CO.


County Rice State Kansas

Sec. 3 (Blk. Twp.) 18 (Sur. Rge.) 8W Map No.

Operator Ash-Mar Drlg.

Well No. 4 Farm Janssen

Elev. k773 Location NW SW NW

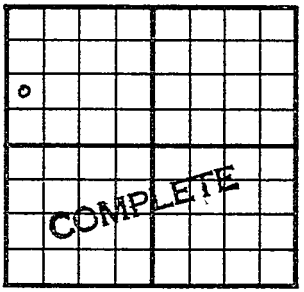

990 Ft. From S Line NW

330 Ft. From W Line Quarter

1st. Report

Completion MAR 2 4 1954

Remarks Geneseo Pool

Ash-Mar - Contr.

Spudding Date 1-4-54

Drlg. Data Oil well TD 3282

8" @ 184 Br. lime 2819 Lans. 2847

Cong. 3218 Arb. 3238 TD 3282

5" @ 3282 23/ 3278-82 50 mud-acid

150 A 3/4 boph 3 hr. 500 A

S/ 14 bo 2 hr. Comp. 26 bopd 91% wtr.

J. G. McGEHEE