


Section 3 Township 18 Range 8 W

Well No. # 5 Kalina

Company Dozier Oil

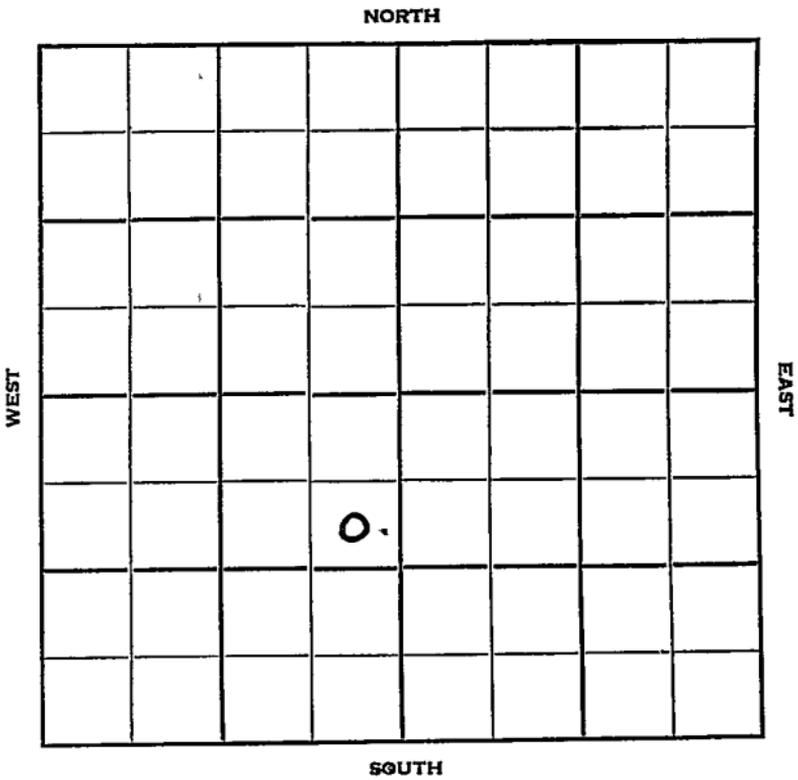

Sec. 3 Twp. 18 R. 8 W

Well No. # 5 Kalina Farm

Dozier Oil Company

Stag Contractor

Edwards


990 Ft. from N. Line

\_\_\_\_\_ Ft. from S. Line

330 Ft. from E. Line

\_\_\_\_\_ Ft. from W. Line

SE NE SW

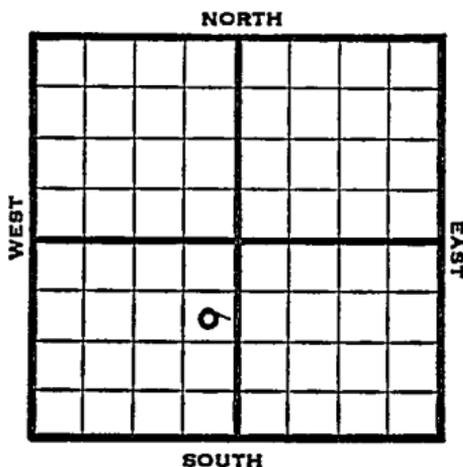

1952	Elev. 1776' REPORT
5/28	Location
6/11	Heeb' 2699' Br li 2819' KC 2843' Cong. 3210' Drlg. 3221'
6/18	Arb. 3238 RTD 3287 5" @ 3243 CO 3287 Fill up 2080' fluid 890 oil PB 3277 S/16 Bfph 90% wtr PB 3248 S/22 BO & 36 BWPH for 6 hrs. POP
6/25	NR
7/2	"
7/9	"
7/16	Spud 5-31-52 Oil well TD 3287' 8" @ 233' Heeb 2699' Br. lime 2819' KC 2843' Cong. 3210' Arb. 3238' TD 3287' 5" @ 3243' CO to 3287' FU 2080' fluid 8% oil PB 3277' S/16 BFPH 90% water PB 3248' S/22 BO 36 BWPH 6 hr. Comp. 56 BOPD 61% water.
<b>COMPLETED</b>	



