


Ellis

Section 34 Township 13 Range 20W

Well No. 1 Kingsley

Company Lewis Drlg.

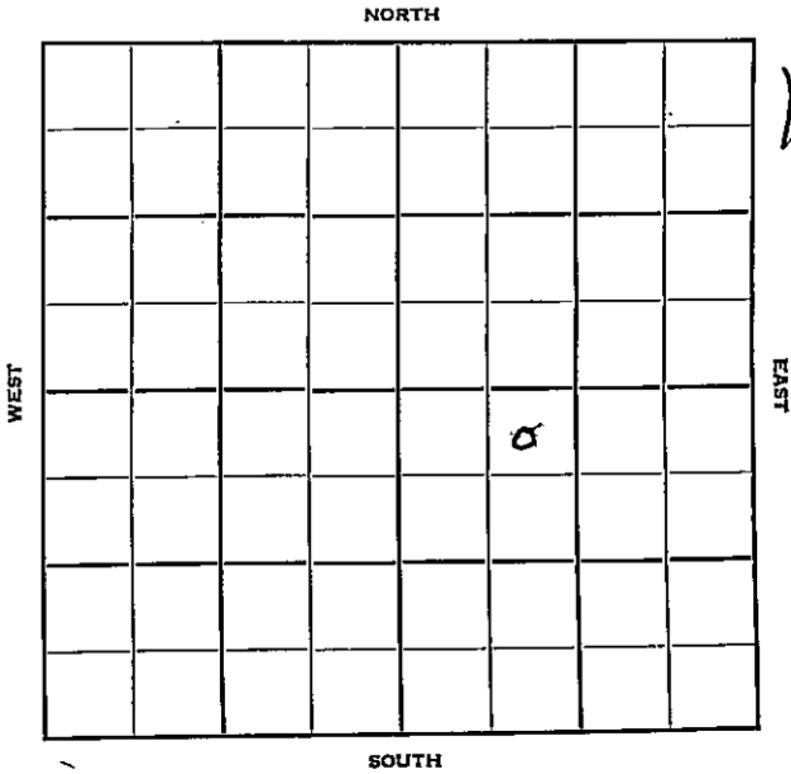

Sec. 34 Twp. 13 R. 20 W

Well No. # 1 Kingsley Farm

Lewis Drlg. Company

Lewis Drlg. Contractor


330 Ft. from N. Line

_____ Ft. from S. Line

_____ Ft. from E. Line

990 Ft. from W. Line

NE NW SE

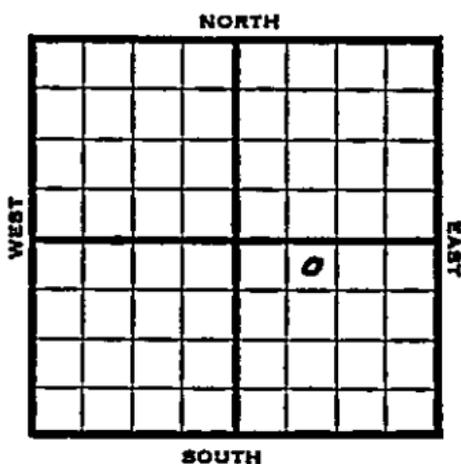

1952 Elev. 2257' REPORT

12/17 Spud 12-11-52
8" @ 161 Anhy 1563' Top 3260'
Drlg. 3277'

12/25 Drlg 3277

1/1 Heeb 3486 Tor 3505 Lans 3523 Arb 3841-
44RTD 5" @ 3842 DD 3852 s/3 BOPH 12 Hrs

1/8 NR

1/22 Testing

1/28 Spud 12-11-52
Oil Well
TD 3852
8" @ 161
Anhy 1563, Top 3239, Heeb 3486,
Tor 3505, Lans 3523, Arb. 3841
TD 3844
5" @ 3842
DD 3852 S/3 boph 12 hrs. 500A
S/31 boph P/31 bopd
Comp. 521 bopd

COMPLETED

County Ellis State Kansas

Sec. 34 (Blk. Twp.) 13 (Sur. Rge.) 20W Map No.

Operator Lewis Drlg.

Well No. 1 Farm Kingsley

Elev. Location NE NW SE

330 Ft. From N Line SE

990 Ft. From W Line Quarter

Ist. Report DEC 17 1952

Completion

Remarks

Lewis Drlg. - Contr.

Spudding Date 12-11-52

Drlg. Data

8" @ 161 Anhy 1563 Top. 3260

drlg. 3277

