


Section 34 Township 13 Range 20 W

Well No. #2 Kingsley

Company Lewis Drlg.

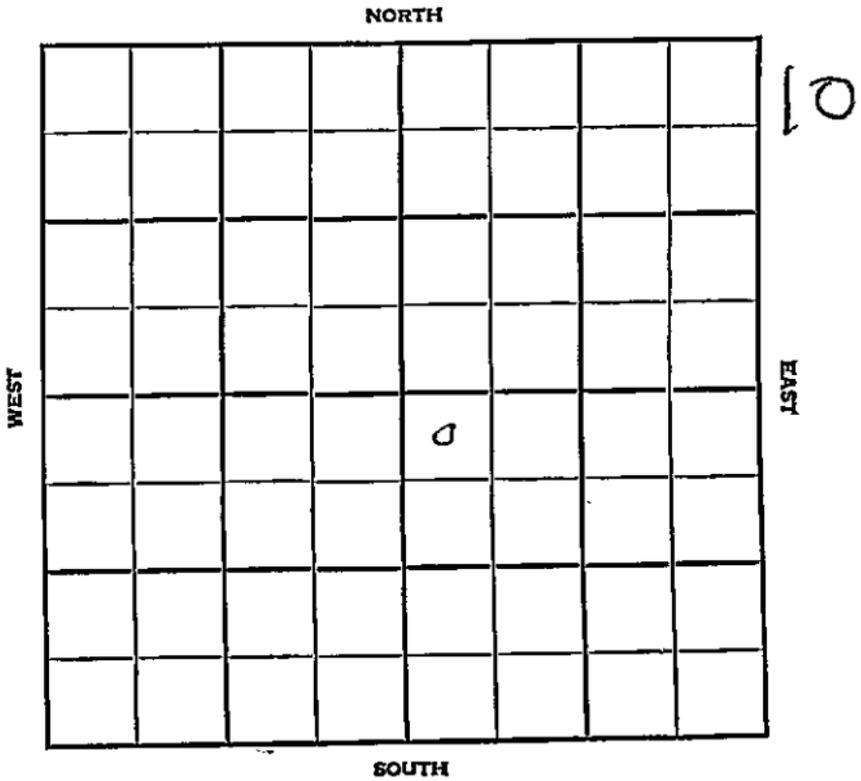

Ellis

KANSAS

SEC. 34	TWP. 13	R. 20W
------------	------------	-----------

WELL NO.

#2 Kingsley

FARM

COMPANY

Lewis Drlg.

CONTRACTOR

Co. Tools

Pleasant


_____ Ft. from N. Line

_____ Ft. from S. Line

_____ Ft. from E. Line

_____ Ft. from W. Line

NW NW SE

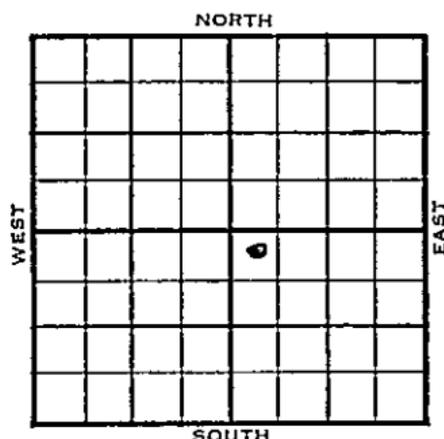

1955	ELEVATION 2254'	FIRST REPORT
8/10	RUR	
12-21	Comm. 8-8-55 8 5/8" @ 155 DST 3564-96 op 1 hr. 1200' GIP, rec 1340' wtry oil, 40' wtr., 30' sw, 1125/20 DST 3610-23 op 1 hr. rec. 340' GIP, 350' hocm, 90' wtr., 1280# DST 3647-57 op 1 hr. rec 15' drlg. mud 370/15" DST 3692-3713 op 1 hr. rec. 70' mud & wtr. 0/30" DST 3708-20 op 1/2 hr. rec. 30' drlg. mud 0/15" 5 1/2" @ 3857 Co DD 3872, 250 A, S/ 1/2 bo, 500 A, S/ wtr. PB 3845, 22/ 3832-38, B/ 2 bwph, PB 3750, 23/ 3750-54, 20/ 3611-16 B/ 9 go, 21 gw, 2500 A S/ 40 bw 1 boph, PB 3600, 12/ 3569-72 S/ 5 1/4 bo, 7 1/2 bwph, Comp. 30 BOPD, 70% wtr. H. 3479 L. 3519, A. 3862 TD 3863	

County Elis Elev. _____
 Sec. 34 Twp. 13 Rge. 20W
 Company Lewis Drlg.
 FarmName Kingsley No. 2

TOPS	DEPTH	LOG	DATUM
Anb.			
Tr.			
H.			
Tr.			
Dg.			
Bl.			
L.			
K.C.			
B.K.C.			
Ce.			
C.			
M.			
M.			
K.			
Mz.			
Me.			
V.			
S.			
S.			
A.			
R.			
PE.			
G.			
T.D.			

Loc. in Sec. NW NW SE

Geol. _____

Contr. _____

Co. tools

Pool

Pleasant

FIRST REPORT
 0
 AUG 10 '55

Date Comm. RUR

~~Handwritten signature~~

Co.
Lse.
No.
Sec.
T.
R.

County	Elvis	Elev.	2254
Sec.	34	Twp.	13
		Rge.	20W
Company	Lewis Drlg.		
FarmName	Kingsley	No.	2

TOPS	DEPTH	LOG	DATUM	Loc. in Sec.
Anh.				NW NW SE
Tr.				
H.	3479		1225	
Tr.				
Dg.				
BL.				
L.	3519		1265	
K.C.				Geol.
B.K.C.				Contr.
Ce.				Co. tools
C.				
M.				
M.				
K.				Procl. Pleasant
Mz.				
Me.				
V.				
S.				
S.				
A.	3862		1608	
R.				
Pe.				
G.				
TD.	3863			

Date Comm.	8-8-55	DEC 2 1 1955
8 5/8" @ 155	DST 3564-96	open 1 hr.
1200' GIP	Rec. 1340' wtry oil	40' wtr.
30' sw	1125/20" DST 3610-23	open 1 hr.
rec. 560' sw	1200# DST 3611-26	-
open 1 hr.	rec. 340' GIP	350' hocm
90' wtr.	1280# DST 3647-57	open 1 hr.
rec. 15' drlg. mud	370/15" DST 3692-3713	
open 1 hr.	rec. 70' mud & wtr.	0/30"