

KANSAS


Ellis

FORM 51 5M PETROL

Section 33 Township 13 Range 20W

Well No. 1 Rankin

Company Eldorado Ref. etal

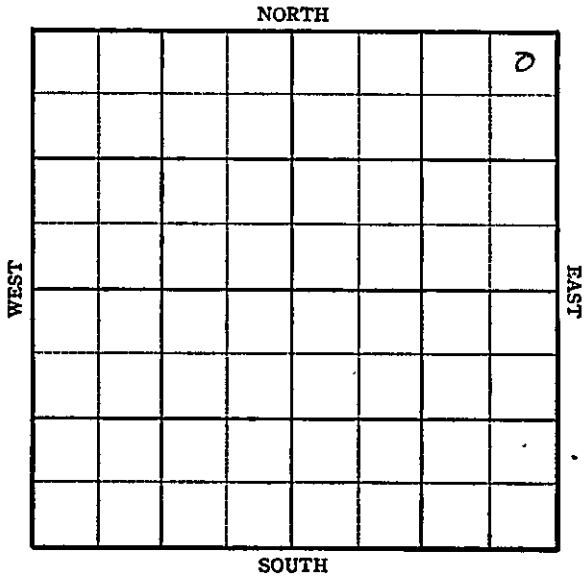

KANSAS

Sec. 33 Twp. 13 R. 20W

Well No. #1 Rankin Farm

Eldorado Ref. et al Company

Wildcat


330 Ft. from N. Line

 Ft. from S. Line

330 Ft. from E. Line

 Ft. from W. Line

NE/c

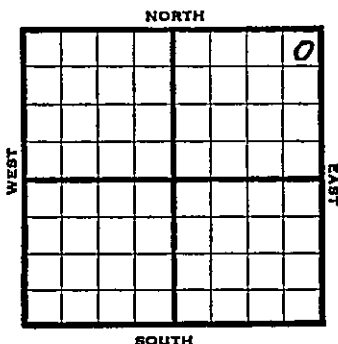

1945

Elev. 2271 REPORT

10/31

8" @ 246
Anhy. 1570
Drlg. 2458

11/7

Drlg. 3494'

11/14

Lans 3589
BKC 3824
Arb. 3918
TD 3950'

ABANDONED

KANSAS Kansas Pool Name Wildcat
 Map No. 70 Sec. 33 Twp. 13 R. 20W
 Well No. 1 Rankin

Eldorado Ref. etal

Company

FIRST REPORT

Contractor

NE/c


SECTION PLAT

330 Ft. from N. Line

 Ft. from S. Line

330 Ft. from E. Line

 Ft. from W. Line

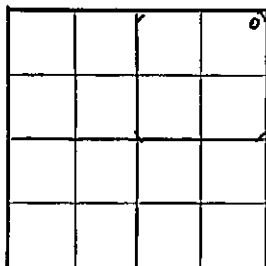

Ellis County

Location

Rig up

Drilling and Remarks:

8"-246

anhy 1570

2458

RECORD

Cased in., ft.

Sand

Gas

Oil

Total Depth

PRODUCTION

1st 24 hrs. Nat.

1st 24 hrs. after shot

Gas Cu. Ft.

Dry Hole

Abandoned

Date

OCT 31 1945 19

S. J. LEWIS Scout

KANSAS Kansas Pool Name WildcatMap No. 70 Sec. 33 Twp. 13 R. 20WWell No. 1 Rankin

Eldorado Ref. etal Company

ABANDONED Contractor

NE/c

E/227/
SECTION PLAT330 Ft. from N. Line Ft. from S. Line330 Ft. from E. Line Ft. from W. Line

Ellis County

			2

Location Rig up

Drilling and Remarks:

Lane 3589B/KC 3824QX 3918

RECORD

Cased in., ft.Sand Gas Oil Total Depth 3950

PRODUCTION

1st 24 hrs. Nat. 1st 24 hrs. after shot Gas Cu. Ft.Dry Hole Abandoned

Date

NOV 14 1945 19

S. J. LEWIS Scout