


Section 3 Township 18 Range 8W

Well No. #1 Kalina

Company Dozier Oil

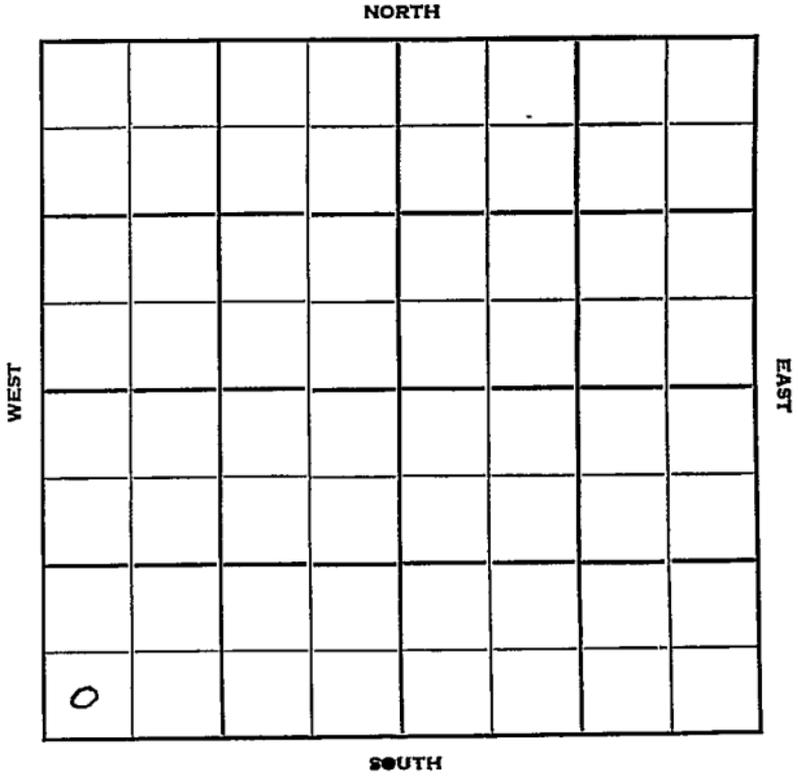

Rice

KANSAS

Sec. 3 Twp. 18 R. 8 W ✓

Well No. # 4 Kalina Farm

Dozier Oil Company

Stagg Drlg. Contractor

Edwards Pool


Ft. from N. Line

NORTH

330 Ft. from S. Line

Ft. from E. Line

330 Ft. from W. Line

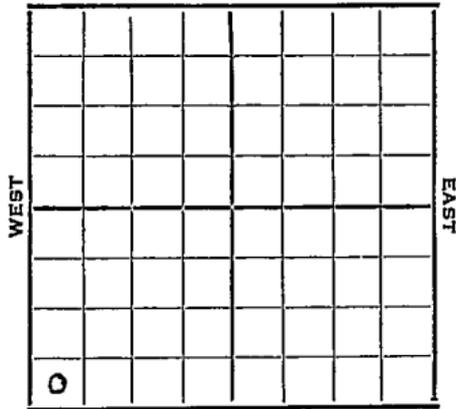

SW SW SW

SOUTH

1951 Elev. 1770' REPORT

12/5 Spud 12-1-51  
8" @ 214  
Drlg. 700'

1952  
1/16 Spud 12-1-51  
Oil Well TD 3285  
8" @ 214  
Heeb. 2705 Br. Li 2830  
KC 2854 Cong. 3214  
Simp. 3236 Arb. 3283  
TD 3285 5" @ 3283  
CO to 3285 500 A Comp. Echo pot.  
2906 BOPD

**COMPLETED**

County Rice State Kansas

Sec. 3 (Blk. Twp.) 18 (Sur. Rge.) 8W Map No.

Operator Dozier Oil

Well No. 4 Farm Kalina

Elev. Location SW SW SW

0					

FIRST REPORT

330 Ft. From S Line SW

330 Ft. From W Line Quarter

Ist. Report DEC 5 1951

Completion

Remarks

Stagg Drlg. - Contr.

Spudding Date 12-1-51

Drlg. Data Edwards Pool

8" @ 214 drlg. 700

J. E. TYRA

