
FORM 51 25M 8-50 WESTERN O.W.W.O.

Rice KANSAS

Section 3 Township 18 Range 8 W

Well No. # 3 ~~Keline~~ KALNIA

Company Dozier Oil

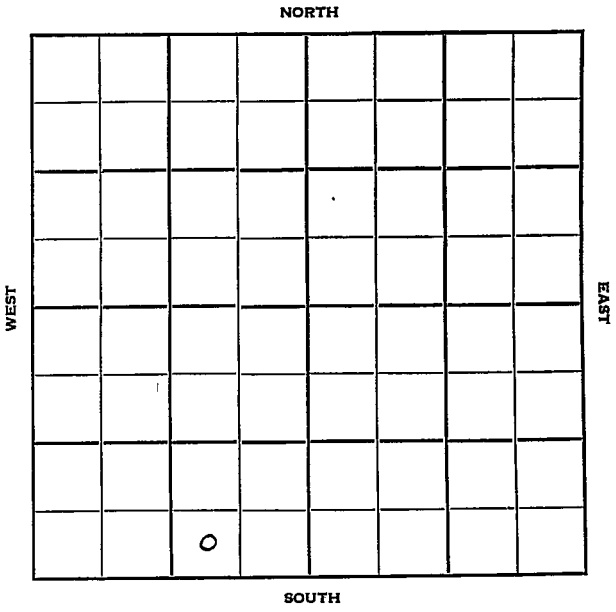

FORM 252-B
10M 11-50 PETRO

O.W.W.O. Rice KANSAS

Sec. 3 Twp. 18 R. 8 W

Well No. # 3 ~~Keline~~ KALNIA Farm

Dozier Oil Company

Lewis Drlg. Contractor

Geneseo Pool


Ft. from N. Line

330 Ft. from S. Line

990 Ft. from E. Line

Ft. from W. Line

SW SE SW

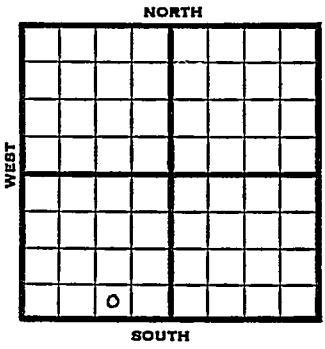

1951	Elev. 1771' REPORT
4/11	R U R
4/25	Spud 4-12-51 D&A TD 3310 8" @ 231 Heeb. 2712 Br. lime 2836 Lans. 2860 Cong. 3230 Kinderhook 3251' Viola 3277 Simp 3290 TD 3310 D&A ABANDONED
	O.W.W.O.
1954 1/13	OWWO for SWD Lans 2860', Cong 3230', Kh 3251', Viola 3277', Simp 3290' OTD 3310' To DD for SWD
1/20	SWD
1/27	"

OVER

O.W.W.O.

1954
2/3

SWD Well
TD 4000'
Lans 2860', Cong 3230', Kh. 3251'
Viola 3277' & Simp. 3290'
OTD 3310'
Arb. 3334', Gr Wash 3921'
TD 4000'
5" @ 3350'
CO to 4000 1000A
Comp. for SWD Well

ABANDONED

FORM 275 FOR SALE BY KANSAS BLUE PRINT CO.


County Rice State Kansas

Sec. 3 (Blk. Twp.) 18 (Sur. Rge.) 8W Map No.

Operator Dozier Oil

Well No. 3 Farm Kaline

Elev. Location SW SE SW

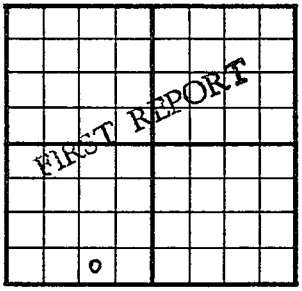

330 Ft. From S Line SW

990 Ft. From E Line Quarter

1st. Report APR 11 1951

Completion

Remarks

Spudding Date

Drlg. Data Geneseo Pool

R U R

J. E. TYRA

FORM 275 FOR SALE BY KANSAS BLUE PRINT CO.


County Rice State Kansas

Sec. 3 (Blk. Twp.) 18 (Sur. Rge.) 8W Map No.

Operator Dozier Oil

Well No. 3 Farm Kaline

Elev. 1771 Location SW SE SW

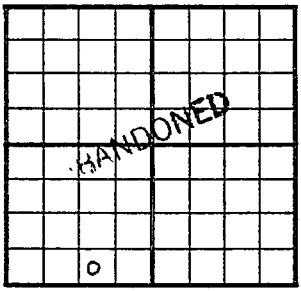

330 Ft. From S Line SW

990 Ft. From E Line Quarter

1st. Report

Completion APR 25 1951

Remarks Geneseo Pool

Spudding Date 4-12-51

Drlg. Data D & A TD 3310

8" @ 231 Heeb. 2712 Br. lime 2836

Lans. 2860 Cong. 3230 Kinderhook 3251

Viola 3277 Simp. 3290-3310 TD

D & A

J. E. TYRA

FORM 275 FOR SALE BY KANSAS BLUE PRINT CO.

O.W.W.O.

County Rice State Kansas

Sec. 3 (Blk. Twp.) 18 (Sur. Rge.) 8W Map No.

Operator Dozier Oil

Well No. 3 Farm Kalnia

Elev. 1771 Location SW SE SW

330 Ft. From S Line SW

990 Ft. From E Line Quarter

1st. Report JAN 1 3 1954

Completion O.W.W.O.

Remarks OWWO for SWD
Lewis Drlg. - Contr.

Spudding Date

FIRST REPORT

o

Drlg. Data

Lans. 2860 Cong. 3230 Kn. 3251

Viola 3277 Simp. 3290 OTD 3310

to DD for SWD

J. G. McGEHEE

FORM 275 FOR SALE BY KANSAS BLUE PRINT CO.

O.W.W.O.


County Rice State Kansas

Sec. 3 (Blk. Twp.) 18 (Sur. Rge.) 8W Map No.

Operator Dozier Oil

Well No. 3 Farm Kalnia

Elev. 1771 Location SW SE SW

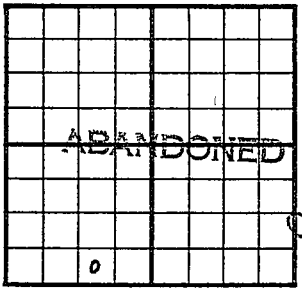

330 Ft. From S Line SW

990 Ft. From E Line Quarter

1st. Report

Completion FEB 3 1954

Remarks (OWWO) for SWD

Lewis Drlg. - Contr.

Spudding Date

Drlg. Data SWD well TD 4000

Lans. 2860 Conq. 3230 Kh. 3251

Viola 3277 Simp. 3290 OTD 3310

Arb. 3334 Gr. Wash 3921 TD 4000

5" @ 3350 CO to 4000 1000 A

Comp. for SWD well

J. G. McGEHEE