


DX 78-1 Rush

KANSAS

Section 21 Township 18 Range 16W

Well No. #1 Monson

Company Solar Oil

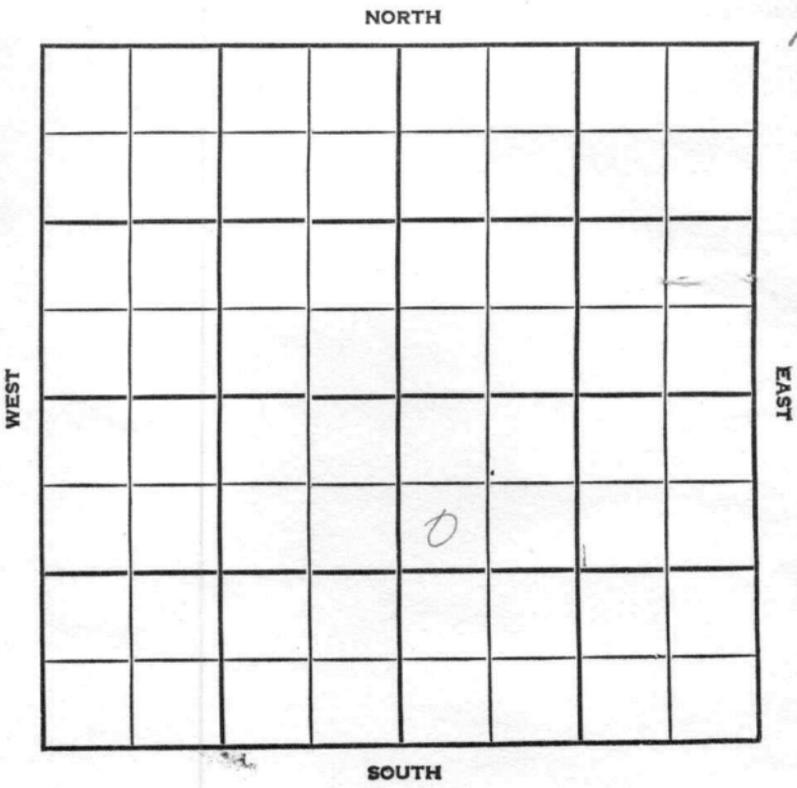

Rush

KANSAS

SEC. 21	TWP. ## 18	R. 16W
------------	---------------	-----------


WELL NO. #4 Monson FARM

COMPANY Solar Oil

CONTRACTOR Lewis Drlg.

Otis-Albert

\_\_\_\_\_ FT. FROM N. LINE  
 \_\_\_\_\_ FT. FROM S. LINE  
 \_\_\_\_\_ FT. FROM E. LINE  
 \_\_\_\_\_ FT. FROM W. LINE

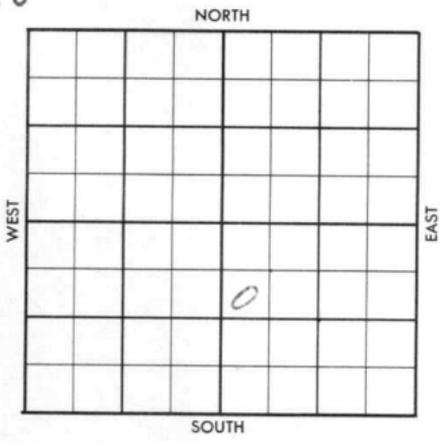

SW NW SE

1956	ELEVATION # 1989'	REPORT
------	-------------------	--------

6-6 MIR

7-3. Comm . 6-6-56  
 8 5/8" @ 1042 w/300  
 DST 3587-3607 op 1 2/3 hr. rec. 170'  
 oil / 60' muddy oil / 40' OCM / 70'wtr.  
 870/20".  
 DST 3608-39 op 80 min, gas to surf.  
 9 min, rec. 180' OCM / 180' muddy oil  
 / 850' oil & oily wtr. / 180' wtr.  
 BHP 820#  
 5 1/2" @ 3609, 54/ 3598-3604  
 FU 1835' oil, 20 hrs.  
 P/ 50 bopd, no/wtr.  
 H. 3228', L. 3289', Reag. 3578',  
 Camb. 3634',  
 TD 3639'

COMPLETED



County Rush Elev. 1989  
 Sec. 21 Twp. 18 Rge. 16W  
 Company Solar Oil  
 Farm Name Monson No. 4

TOPS	DEPTH	LOG	DATUM	Loc. in Sec.
Anh.				SW NW SE
Tr.				
H.	3228			
Dg.				
Bl.				
L.	3289			Geol.
K.C.				
B.K.C.				Contr.
Ce.				Lewis Drlg.
C.				
M.	3587	78		Pool
K.				Otis-Albert
Mz.				
Me.				
V.				
S.				
S.				
A.				
R.				
Pe.	3634			COMPLETE
G.				
T.D.	3639			

Date Comm. JUL 3 1956  
 M I R JUN 13 '56 6-6-56 8 7/8 1042/300  
 \$ 26.55 JUN 20 '56 DST 3587-3607  
 1 2/3 hrs see 170' oil + 60' Mdy  
 oil + 40' ocm + 70' wt  
 870/28" ST<sub>2</sub> DST 3608-39 cap  
 80" g to 5 9" see 180' ocm +  
 180' Mdy oil + 850' oil & oily wt  
 + 180' wt BHP 820 5 1/2 @  
 3639 JUN 27 '56 54/3598-3604 FU.

21-18-16W SW NW SE

1835' oil 20 hrs POP JUL 3 '56

P. 50 Bopd no/wto.

21-18-16W

SW NW SE