

KANSAS

FORM 51 5M 4-41 PETROL


Russell

Section 24 Township 15 Range 14-W

Well No. #5 Mai "A"

Company Cities Service Oil

NORTH **Trapp Pool**

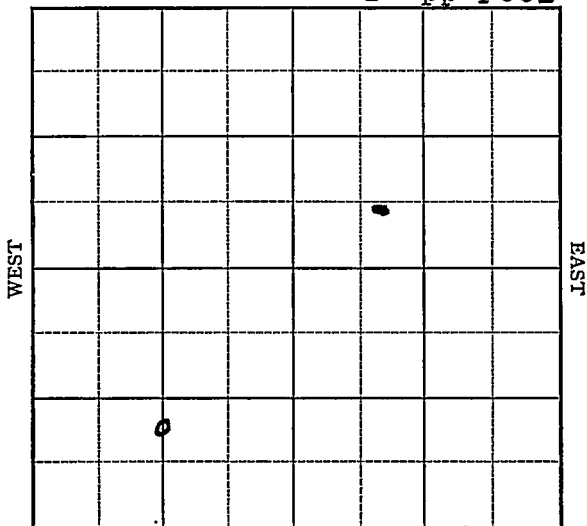

SOUTH

Sec. 24 Twp. 15 R. 14-W

Well No. #5 Mai "A" Farm _____

Cities Service Oil Company _____

(Trapp)


_____ Ft. from N. Line

990 Ft. from S. Line

_____ Ft. from E. Line

1320 Ft. from W. Line

Elev. 1899

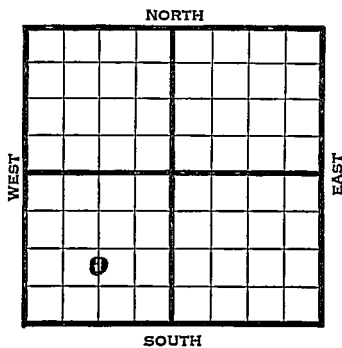

1941	REPORT
4/30	Derrick.
5/8	10" - 327' Drlg. 1700'
5/15	Drlg. 3176'
5/22	Arb. 3339' 6" - 3340'
	T.D. 3345' 2650' oil 14½ hours.
5/27	Arb. 3339'
	6" - 3340'
	T.D. 3345'
	2000 acid.
	Echometer potential 1321 bbls.
	39. Gravity
	COMPLETED

