


Section 23 Township 34 Range 3E

Well No. #1 Harvey

Company Martin & Cash

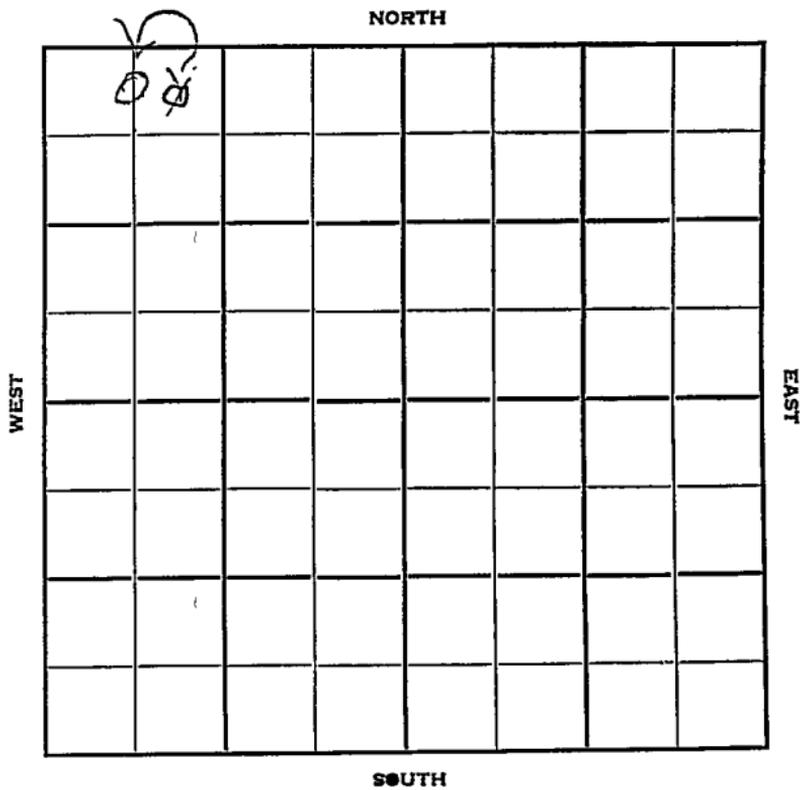

Cowley

KANSAS

Sec. 23

Twp. 34

R. 3E

Well No. #1 Harvey Farm

Martin & Cash Company

Martin & Cash - Contr. Contractor

Wildcat

330' Ft. from N. Line


Ft. from S. Line

Ft. from E. Line

660
990' Ft. from W. Line

~~NE NW NW~~

CNL NWNW

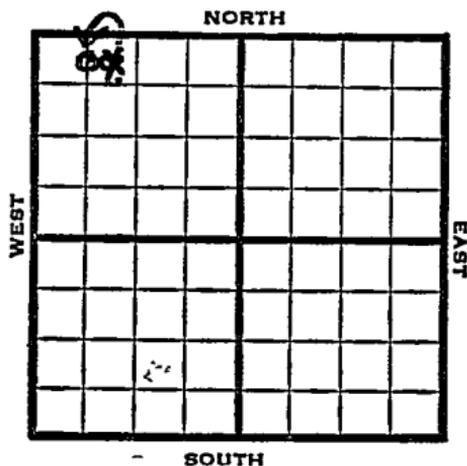

1952

Elev. 1091 REPORT

7/23

Spud 7-16-52
8" @ 101'
Stal 2124
Drlg. 2200

8/20

Spud 7-16-52 Oil Well
TD 3296 8" @ 101'
Stal 2124 Bart 3278
TD 3283 5" @ 3283 DD 3296
Hydro F/75 boph Comp. 2382-bopd

COMPLETED

County Cowley State Kansas

Sec. 23 (Blk. Twp.) 34 (Sur. Rge.) 3E Map No.

Operator Martin & Cash

Well No. 1 Farm Harvey

Elev. _____ Location NE NW NW

0					

330 Ft. From N Line NW

990 Ft. From W Line Quarter

1st. Report JUL 23 1952

Completion _____

Remarks _____

Martin & Cash. - Contr.

Spudding Date 7-16-52

Drlg. Data Wildcat

8" @ 101 Stal. 2124 drlg. 2200

J. G. MCGEHEE

County Cowley State Kansas

Sec. 23 (Blk. 34 (Sur. 3E (Twp.) Rge.) Map No.

Operator Martin & Cash

Well No. 1 Farm Harvey

Elev. 1091 Location C N L NW NW

o					

COMPLETE

330 Ft. From N Line NW

660 Ft. From W Line Quarter

1st. Report

Completion AUG 20 1952

Remarks Wildcat

Martin & Cash - Contr.

Spudding Date 7-16-52

Drlg. Data Oil well TD 3296

8" @ 101 Stal. 2124 Bart. 3278

TD 3283 5" @ 3283 DD 3296 Hydro.

F/ 75 bophi - Comp. 2382 bopd