


Section 35 Township 13 Range 20W

Well No. 2 Dreiling "C"

Company Sunray

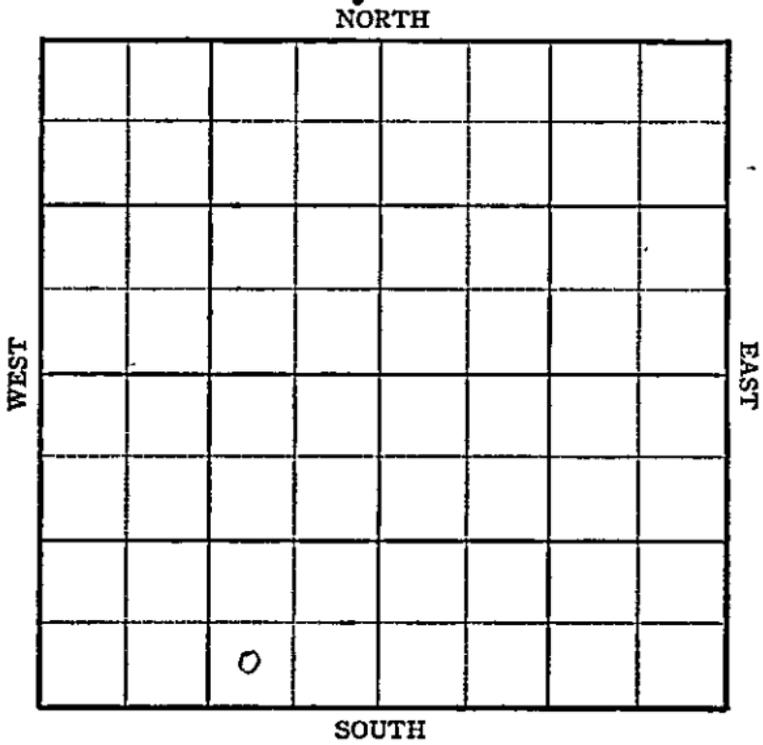

Sec. 35 Twp. 13 R. 20-W

Well No. #2 Drilling "C" Farm


Sunray Company

\_\_\_\_\_ Ft. from N. Line

330 Ft. from S. Line

990 Ft. from E. Line

\_\_\_\_\_ Ft. from W. Line

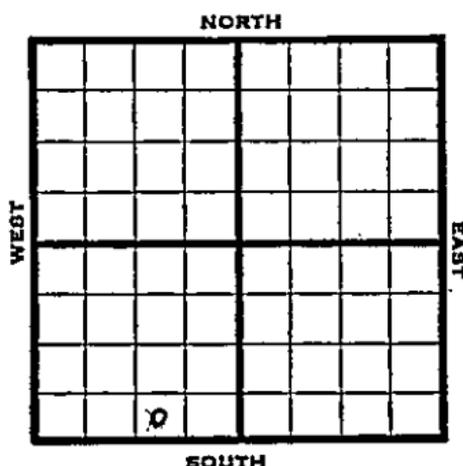

SW SE SW Elev. 2227

REPORT

1945

- 9/19 - RUR
- 9/26 No report
- 10/3 Anhy. 1515  
8" @ 1525  
Drig. 3620'
- 10/10 Lans 3528  
BKC 3769  
Cong 3813  
Arb. 3835  
TD 3840 SO  
5" @ 3836 RUST
- 10/17 500' oil 2 hrs.  
500 acid.  
Swab 10 oil per hr. 5 hrs.
- 10/24 " " " "
- 10/31 Arb. 3835  
5" @ 3836  
500 acid.  
TD 3840'  
Pump 347 Pot.  
Grav. 33.0

COMPLETED

KANSAS Kansas Pool Name Pleasant

Map No. 70 Sec. 35 Twp. 13 R. 20W

Well No. 2 Drilling "C"

Sunray Company

FIRST REPORT Contractor

SW SE SW

## SECTION PLAT


\_\_\_\_\_ Ft. from N. Line

330 \_\_\_\_\_ Ft. from S. Line

990 \_\_\_\_\_ Ft. from E. Line

\_\_\_\_\_ Ft. from W. Line

Ellis County

Location \_\_\_\_\_

Rig up \_\_\_\_\_

Drilling and Remarks:

RUR

## RECORD

Cased \_\_\_\_\_ in., \_\_\_\_\_ ft.

Sand \_\_\_\_\_

Gas \_\_\_\_\_

Oil \_\_\_\_\_

Total Depth \_\_\_\_\_

## PRODUCTION

1st 24 hrs. Nat. \_\_\_\_\_

1st 24 hrs. after shot \_\_\_\_\_

Gas \_\_\_\_\_ Cu. Ft.

Dry Hole \_\_\_\_\_

Abandoned \_\_\_\_\_

Date

SEP 1 9 1945 19

S. J. LEWIS Scout

Pool Name Pleasant

KANSAS

Kansas

Map No. 70 Sec. 35 Twp. 13 R. 20WWell No. 2 Dreiling "C"

Sunray

Company

**COMPLETED**

Contractor

SW SE SW

E. 2227  
SECTION PLAT         Ft. from N. Line330 Ft. from S. Line990 Ft. from E. Line         Ft. from W. Line


Ellis County

Location         Rig up         

Drilling and Remarks:

*Cr 3835*  
*5" @ 3836*  
*5-000 acid*  
*Prof 347 BX*  
*332 gr*

**RECORD**Cased          in.,          ft.Sand         Gas         Oil         Total Depth 3940**PRODUCTION**1st 24 hrs. Nat.         1st 24 hrs. after shot         Gas          Cu. Ft.Dry Hole         Abandoned         

Date

OCT 3 1 1945 19

S. J. LEWIS Scout