


Section 23 Township 34 Range 3E

Well No. ~~#1 Spruill~~ **#2 HARVEY**

Company Martin & Cash

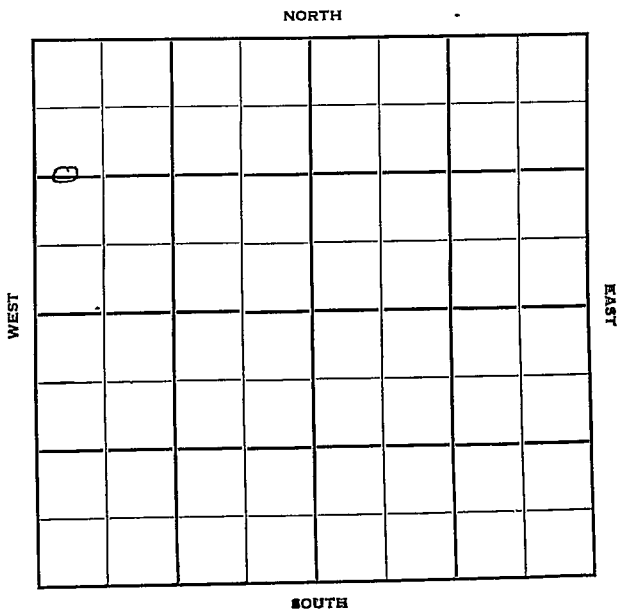

Cowley

KANSAS

Sec. 23 Twp. 34 R. 3E

Well No. #2 Harvey
~~#1 Spruill~~

Martin & Cash

Company

Harvey Pool

Contractor


1247 Ft. from N. Line

_____ Ft. from S. Line

_____ Ft. from E. Line

245 Ft. from W. Line

C $W\frac{1}{2}$ $W\frac{1}{2}$ NW

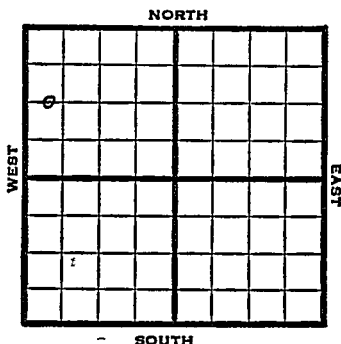

1952

Elev. 1078'

REPORT

10/1

8" @ 100
Spud 9-28-52

1953

1/23

Spud 9-28-52
Oil well TD 3271' 8" @ 100
Stal 2124' Layton 2570' KG 2742'
Cherokee 3058' Bart 3242'
TD 3262' 5" @ 3245 CO to 3262
F/oil Hydro. DD 3271 Hydro.
Comp. 28 BOPD

COMPLETED

County **Cowley** State **Kansas**

Sec. **23** (Blk. Twp.) **34** (Sur. Rge.) **3E** Map No.

Operator **Martin & Cash**

Well No. **1** Farm **Spruill**

Elev. Location **C W $\frac{1}{2}$ W $\frac{1}{2}$ NW**

1247 Ft. From **N** Line **NW**

245 Ft. From **W** Line **Quarter**

1st. Report **OCT 1 1952**

Completion

Remarks

Spudding Date **9-28-52**

Drlg. Data **Harvey Pool**

8" @ 100

Map No. _____ Sec. 23 Twp. 34 R. 3E

Well No. 2 Harvey

Martin & Cash Company

CORRECTION

Contractor

C $W\frac{1}{2}$ $W\frac{1}{2}$ NW

SECTION PLAT

1247 Ft. from N. Line

_____ Ft. from S. Line

_____ Ft. from E. Line

245 Ft. from W. Line

Cowley County

Location _____

Rig up _____

Drilling and Remarks:

Reported
#1 Spruill

RECORD

Cased _____ in., _____ ft.

Sand _____

Gas _____

Oil _____

Total Depth _____

PRODUCTION

1st 24 hrs. Nat. _____

1st 24 hrs. after shot _____

Gas _____ Cu. Ft.

Dry Hole _____

Abandoned _____

Date

JAN 14 1953 19

J. G. MCGEHEE Scout

County Cowley State Kansas

Sec. 23 (Blk. Twp.) 34 (Sur. Rge.) 3E Map No.

Operator Martin & Cash

Well No. 2 Farm Harvey

Elev. 1078 Location C W $\frac{1}{2}$ W $\frac{1}{2}$ NW

1247 Ft. From N Line NW

245 Ft. From W Line Quarter

1st. Report

Completion JAN 23 1952

Remarks Harvey Pool

Spudding Date 9-28-52

Drilg. Data Oil well TD 3271

8" @ 100 Stal. 2124 Layton 2570

KC 2742 Cherokee 3058 Bart. 3242

TD 3262 5" @ 3245 CO to 3262

F/ oil Hydro. DD 3271 Hydro.

Comp. 28 bopd