

KANSAS


FORM 51 5M 6-46 PETROL

Ellis county

Section 35 Township 13 Range 20-W

Well No. #1, French

Company J. G. Farley

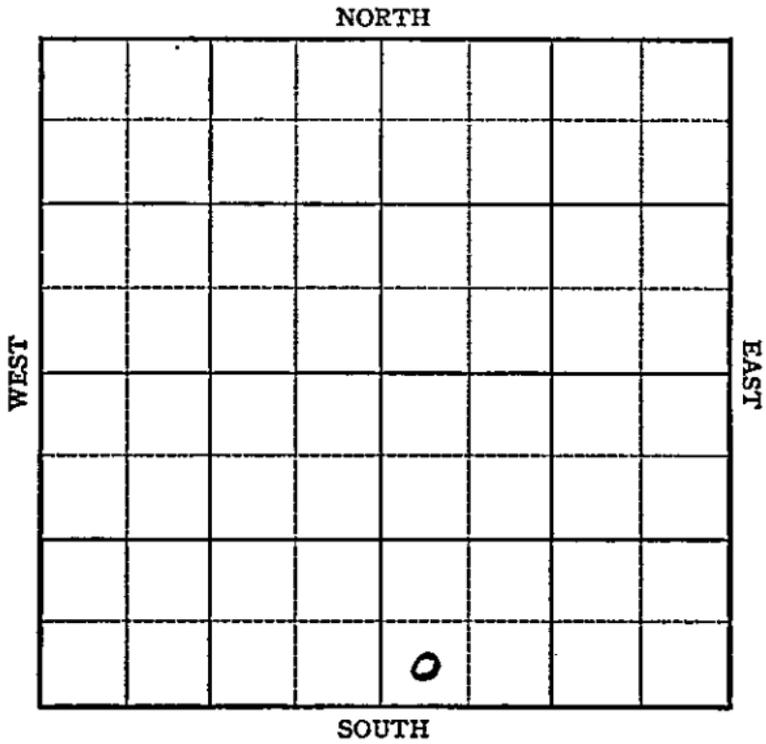

Sec. 35 Twp. 13 R. 20W


Well No. #1 French Farm
J. C. Farley Company

Ft. from N. Line

330 Ft. from S. Line

Ft. from E. Line

330 Ft. from W. Line

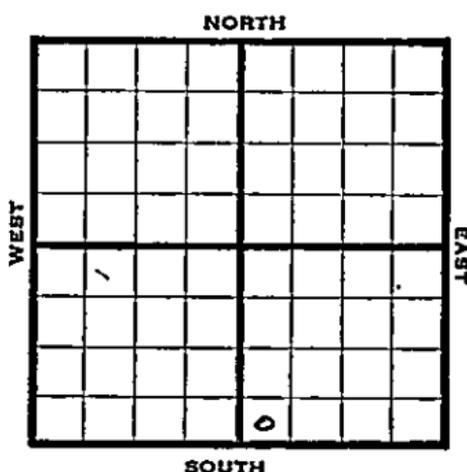

SW SE

1946

2228

REPORT

9/11 8" @ 1525'

WOC

9/18 Drlg 3475'

9/24 " "

10/1 Lans 3542'

Arb 3844

5" @ 3845

TD 3853'

500 acid

10/9 Arb 3844'

TD 3855'

ABANDONED

KANSAS

Form 26 200 Bks. '10-46 Petrol Kansas

No name

Map No. 70 Sec. 35 Twp. 13 R. 20W

Well No. 1 French

J. C. Farley Company

ABANDONED Contractor

SW SE

E1,228.
SECTION PLAT

 Ft. from N. Line

330 Ft. from S. Line

 Ft. from E. Line

330 Ft. from W. Line

Ellis County

RECORD

Location

Cased in., ft.

Rig up

Sand

Drilling and Remarks:

Gas

Oil

Total Depth 3855

CR 9874

PRODUCTION

1st 24 hrs. Nat.

1st 24 hrs. after shot

Gas Cu. Ft.

Dry Hole

Abandoned

Date

OCT 9 1946 19

S. J. LEWIS Scout

