


Section 23 Township 34 Range 3E

Well No. 1 Hallman (*Holman*)

Company Aylward Drig.

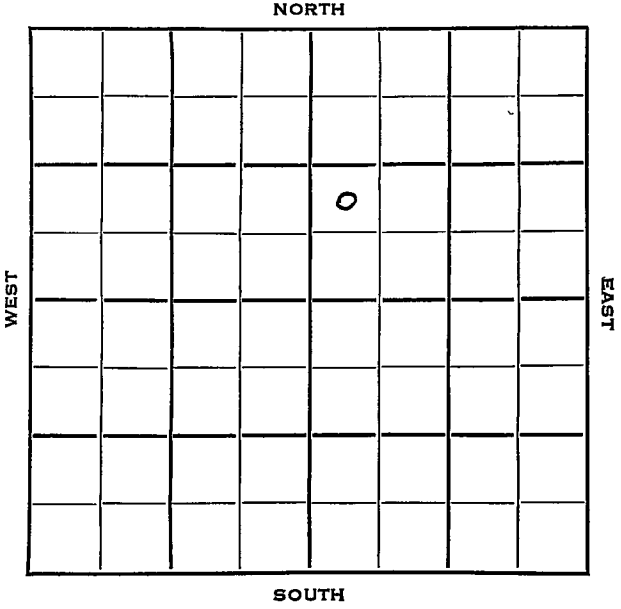

Cowley Kansas

SEC. 23 TWP. 34 R. 3 E

WELL NO. # 1 Hallman FARM

COMPANY # 1 Hallman FARM

CONTRACTOR Aylward Drlg.

Aylward  
Harvey Pool


Ft. from N. Line

990 Ft. from S. Line

Ft. from E. Line

330 Ft. from W. Line

NW SW NE

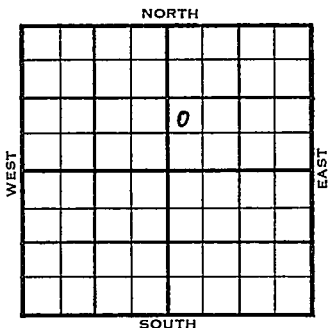

	ELEVATION	REPORT
1954	1185'	

3/31 Spud 3-27-54  
8" @ 100 Drlg. 1740'

5/5 Spud 3-27-54 Oil well TD 3402  
8" @ 100 KC 2882 Cherokee 3184  
Bart. 3358 Bart. sd. 3378  
TD 3392 5" @ 3388 DD 3402 sd-fract  
Comp. 409 BOPD 4% wtr.

**COMPLETED**



