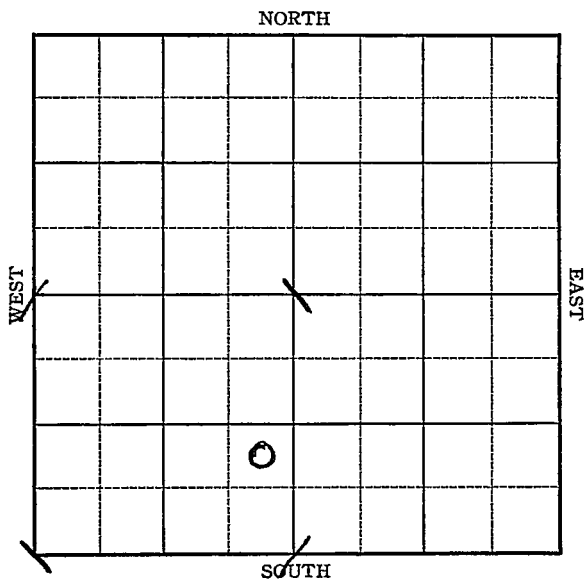


Section 24 Township 15 Range 14-WWell No. 3 - Mai "A"Company Cities Service Oil

Russell KANSAS

Map No. _____ Sec. 24 Twp. 15 R. 14WWell No. 3-Mai-A

Cities Service Oil Company

Contractor _____


FIRST REPORT

_____ Ft. from N. Line

990 Ft. from S. Line330 Ft. from E. Line

_____ Ft. from W. Line

SECTION PLAT

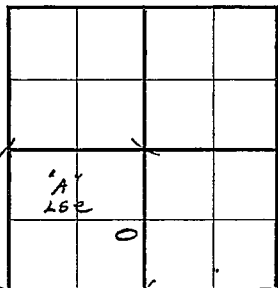

Location _____

Rig up _____

Drilling and Remarks:

BRR.

RECORD

Cased _____ in., _____ ft.

Sand _____

Gas _____

Oil _____

Total Depth _____

PRODUCTION

1st 24 hrs. Nat. _____

1st 24 hrs. after shot 15

Gas _____ Cu. Ft.

Dry Hole _____

Abandoned _____

Date

AUG 18 1937 19H. D. Hatfield Scout

KANSAS

Map No. _____ Sec. 24 Twp. 15 R. 14W

Well No. 3-Mai 'A'

Cities Service Company

Contractor _____

SECTION PLAT

	0		

_____ Ft. from N. Line

990 Ft. from S. Line

330 Ft. from E. Line

_____ Ft. from W. Line

COMPLETED

RECORD

Location _____

Cased _____ in., _____ ft.

Rig up _____

Sand Sil. 3345

Drilling and Remarks:

Gas _____

Oil _____

Total Depth 3352

PRODUCTION

1st 24 hrs. Nat. _____

1st 24 hrs. after shot _____

Gas _____ Cu. Ft.

Dry Hole _____

Abandoned _____

2000 acid

407 bbl oil

26% water

Date

SEP 22 1937

19

H. D. Hatfield

Scout