


Section 35 Township 13 Range 20W

Well No. 1 Drilling "C"

Company Sunray

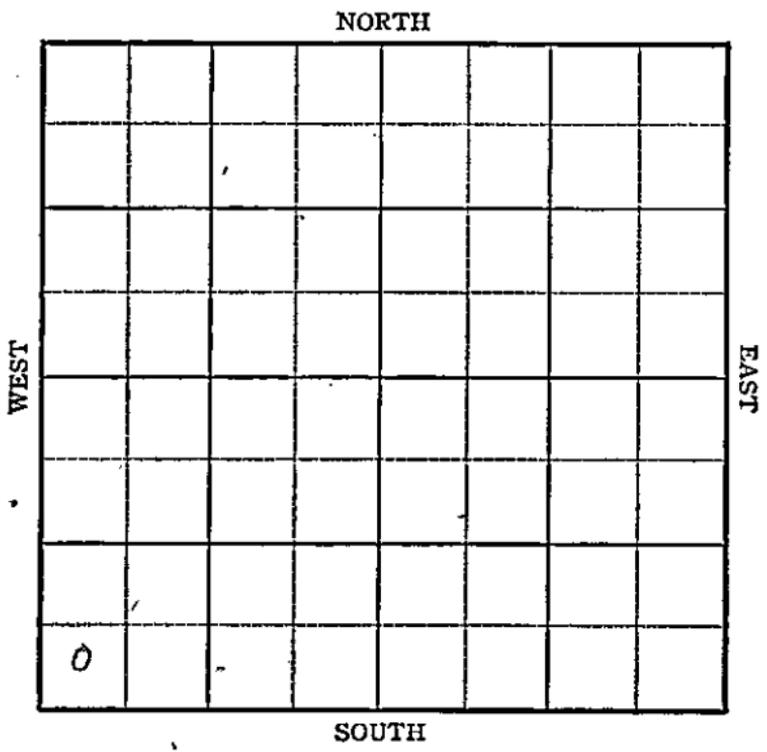

Sec. 35 Twp. 13 R. 20-W

Well No. #1 Drilling "C" Farm

Sunray Company


Ft. from N. Line

330 Ft. from S. Line

Ft. from E. Line

330 Ft. from W. Line

SW/c Elev. 2233

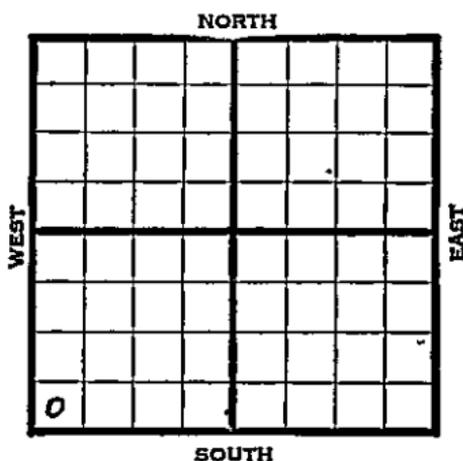

1945

REPORT

7/18 Location
7/26 Drlg. 900
8/1 8" @ 1521
Drlg. 3400
8/8 Lans 3526
Arb. 3831
TD 3837'
5" @ 3832 RUST
8/15 1000 acid
Swab 26 oil per hr. 3 hrs.
8/22 Arb. 3831
5" @ 3832
1000 acid
TD 3837'
Pump 745 Pot.
Grav. 27.0

COMPLETED

KANSAS

Pool Name no. name


Kansas

Map No. 70 Sec. 35 Twp. 13 R. 20WWell No. 1 Drilling "C"Sunray Company

FIRST REPORT

SW/c Contractor

SECTION PLAT

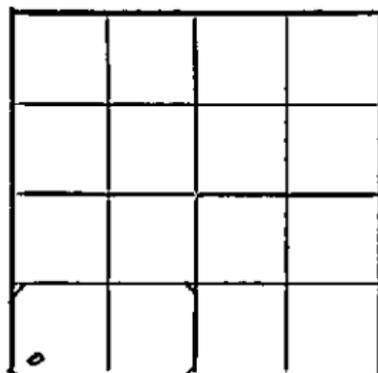 Ft. from N. Line330 Ft. from S. Line Ft. from E. Line330 Ft. from W. Line

Ellis County

Location XRig up

Drilling and Remarks:

RECORD

Cased in., ft.Sand Gas Oil Total Depth

PRODUCTION

1st 24 hrs. Nat. 1st 24 hrs. after shot Gas Cu. Ft.Dry Hole Abandoned

Date

JUL 1 8 1945 19S. J. LEWIS Scout

KANSAS Pool Name Bleasant
 Map No. 70 Sec. 35 Twp. 13 R. 20W
 Well No. 1 Drilling "C"

Sunray

Company

COMPLETED

Contractor

SW/c

E/2233
SECTION PLAT

_____ Ft. from N. Line

330 Ft. from S. Line

_____ Ft. from E. Line

330 Ft. from W. Line

0			

Ellis County

Location _____

Rig up _____

Drilling and Remarks:

*Cert 3831**5' C 3832**1600 acid**Prod 245 P & Y**27° SW***RECORD**

Cased _____ in., _____ ft.

Sand _____

Gas _____

Oil _____

Total Depth 3832**PRODUCTION**

1st 24 hrs. Nat. _____

1st 24 hrs. after shot _____

Gas _____ Cu. Ft.

Dry Hole _____

Abandoned _____

Date

AUG 22 1945 19

S. J. LEWIS Scout