


Russell

Map No. **KANSAS** Sec. 28 Twp. 13 R. 14W

Well No. 3 Holland Farm
Alyward & Skelly Company

990 Ft. from N. Line
Ft. from S. Line
330 Ft. from E. Line
Ft. from W. Line

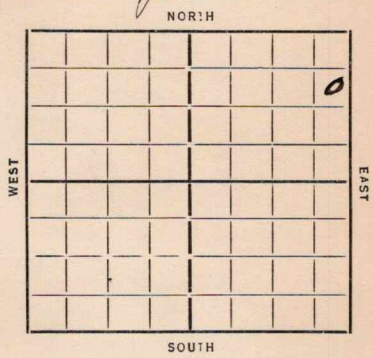

Date	REPORT	O. W. D. D
1935		
1/9	Rig	15 1/2 450
1/17	dly 345	17 1/2 590
1/24	" 1480	10" 875
1/31	" 2430	Gas 2405-10
2/7	" 3140	Overall 3020
	8" 2460 6" 3065	HFW 3090-3100
2/14	6" 3183 5" liner	3278
	Silicious 3281	Pay 3309-11
	1700 oil & S.W.	tubing
2/20	Silicious 3281	
	Oil 3309-11	T 3311
	220 oil	Show Water.
	COMPLETED	
1935		O. W. D. D
5/8	dly 3325	
5/15	Well 3312	T 3325
		D.A.
	ABANDONED	

Map No. 72 Sec. 28 Twp. 13 R. 14W

Well No. 3-Holland

Alyward & Spelly Company

Contractor

FIRST REPORTS

SECTION PLAT

990 Ft. from N. Line

..... Ft. from S. Line

330 Ft. from E. Line

..... Ft. from W. Line

			0

Location.....

Rig up.....

Drilling and Remarks:

Rig

RECORD

Cased.....in.,ft.

Sand.....

Gas.....

Oil.....

Total Depth.....

PRODUCTION

1st 24 hrs. Nat.....

1st 24 hrs. after shot.....

Gas.....Cu. Ft.

Dry Hole.....

Abandoned.....

Date

1-9-35 192.....

ORVAL MANNSCHRECK

Scout

Russell

Map No. *72* Sec. *28* Twp. *13* R. *14W*

Well No. *3-Holland*

Alward + Kelly Company

KANSAS Contractor

COMPLETED

SECTION PLAT

			0

990 Ft. from N. Line

..... Ft. from S. Line

330 Ft. from E. Line

..... Ft. from W. Line

Location.....

Rig up.....

Drilling and Remarks:

*220 oil
show water*

RECORD-

Cased..... in., ft.
 Sand *silicous 3281*
 Gas.....
 Oil *3309-11*
 Total Depth *3311*

PRODUCTION

1st 24 hrs. Nat.....
 1st 24 hrs. after shot.....
 Gas..... Cu. Ft.
 Dry Hole.....
 Abandoned.....

Date

2-20-35 192.....

ORVAL MANNSCHECK

Scout

Map No. 72 Sec. 28 Twp. 13 R. 14^w

Well No. 3- Holland

Alward et al Company

Contractor

FIRST REPORTS

SECTION PLAT

990 Ft. from N. Line

..... Ft. from S. Line

330 Ft. from E. Line

..... Ft. from W. Line

			0

Curd

Location.....

Rig up.....

Drilling and Remarks:

OTU 3311

leg 3325

RECORD

Cased.....in.,ft.

Sand.....

Gas.....

Oil.....

Total Depth.....

PRODUCTION

1st 24 hrs. Nat.....

1st 24 hrs. after shot.....

Gas.....Cu. Ft.

Dry Hole.....

Abandoned.....

Date

5-8-35 192.....

ORVAL MANNSCHRECK

Scout

Map No. 72 Sec. 28 Twp. 13 R. 14W

Well No. 3-Holland

Alward et al Company

Contractor

ABANDONED

SECTION PLAT

990 Ft. from N. Line

Ft. from S. Line

330 Ft. from E. Line

Ft. from W. Line

			0

OWD

Location.....

Rig up.....

Drilling and Remarks:

W + A

RECORD

Cased..... in., ft.

Sand 3312

Gas.....

Oil.....

Total Depth 3325

PRODUCTION

1st 24 hrs. Nat.....

1st 24 hrs. after shot.....

Gas..... Cu. Ft.

Dry Hole.....

Abandoned.....

Date

ORVAL MANN SCHRECK

5-15-35 192.....

Scout