


Section 28 Township 13 Range 14W

Well No. #3 ~~#1~~ Holland "B"

Company V. D. Sidey

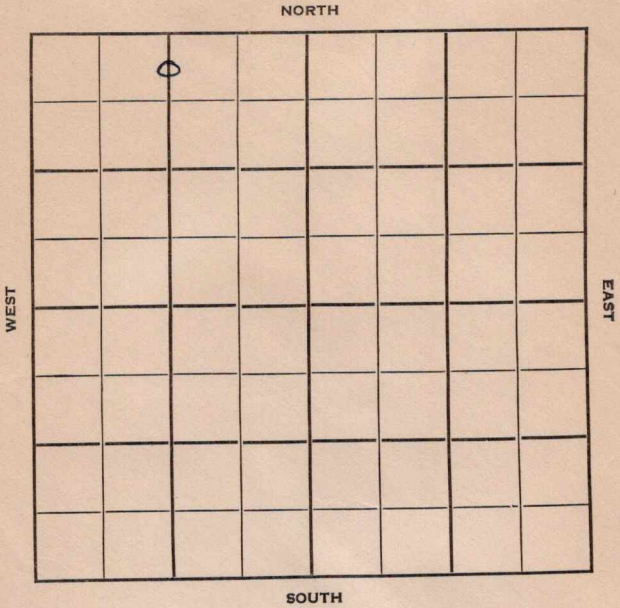

Russell

KANSAS



Sec. 28 Twp. 13 R. 14W

Well No. #3 ~~#4~~ Holland "B" Farm

V. D. Sidey Company

Sidey Contractor


330 Ft. from N. Line

Ft. from S. Line

Ft. from E. Line

1320 Ft. from W. Line

NW 1/4 C N 1/2 N 1/2 NW

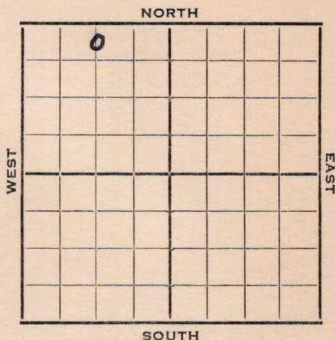

1952 Elev. 1845' REPORT

10/29 Spud 10-25-52
Drlg.

11/5 10" @ 100'
Anhy 880'

11/12 Drlg. 2850'
Arb. 3266 RTD 3268
5" @ 3267'

11/20 NR

11/27 "

12/4 "

12/10 Spud 10-25-52
Oil well TD 3268'
10" @ 100 Anhy 880' Arb. 3265'
TD 3268' 5" @ 3267 CO to 3268
Comp. 100 BOPD

COMPLETED

County Russell State Kansas

Sec. 28 (Blk.) 13 (Sur.) 14W Map No.

Operator V. D. Sidey

Well No. 4 Farm Holland

Elev. _____ Location C N $\frac{1}{2}$ N $\frac{1}{2}$ NW

0					

330 Ft. From N Line NW

1320 Ft. From W Line Quarter

Ist. Report OCT 29 1952

Completion _____

Remarks _____

Sidey - Contr.

Spudding Date 10-25-52

Drlg. Data _____

drlg.

Kansas

Map No. _____ Sec. 28 Twp. 13 R. 14W

Well No. 3 Holland "B"

V. D. Sidey Company

CORRECTION Contractor

C $N\frac{1}{2}$ $N\frac{1}{2}$ NW


SECTION PLAT

330 Ft. from N. Line

_____ Ft. from S. Line

_____ Ft. from E. Line

1320 Ft. from W. Line

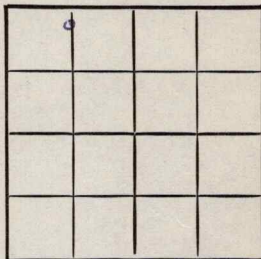

Russell County

Location _____

Rig up _____

Drilling and Remarks:

Reported
#4 Holland

RECORD

Cased _____ in., _____ ft.

Sand _____

Gas _____

Oil _____

Total Depth _____

PRODUCTION

1st 24 hrs. Nat. _____

1st 24 hrs. after shot _____

Gas _____ Cu. Ft.

Dry Hole _____

Abandoned _____

Date

NOV 5 1952

19

J. G. McGEHEE

Scout

County Russell State Kansas

Sec. 28 (Blk. 13) (Sur. 14W) (Twp. 13) (Rge. 14W) Map No.

Operator V. D. Sidey

Well No. 3 Farm Holland "B"

Elev. 1845 Location C N $\frac{1}{2}$ N $\frac{1}{2}$ NW

0					

COMPLETE

330 Ft. From N Line NW

1320 Ft. From W Line Quarter

Ist. Report

Completion DEC 10 1952

Remarks

Sidey - Contr.

Spudding Date 10-25-52

Drlg. Data Oil well TD 3268

10" @ 100 Anhy 880 Arb. 3265

TD 3268 5" @ 3267 CO to 3268

Comp. 100 bopd

J. G. McGEHEE