

KANSAS

Rush


Form 51-5M-7-39-Palace

Section 22 Township 18 Range 16-W -

Well No. #3 Maneth-Brackley

Company Schermerhorn & Winton

NORTH Otis Gas Field

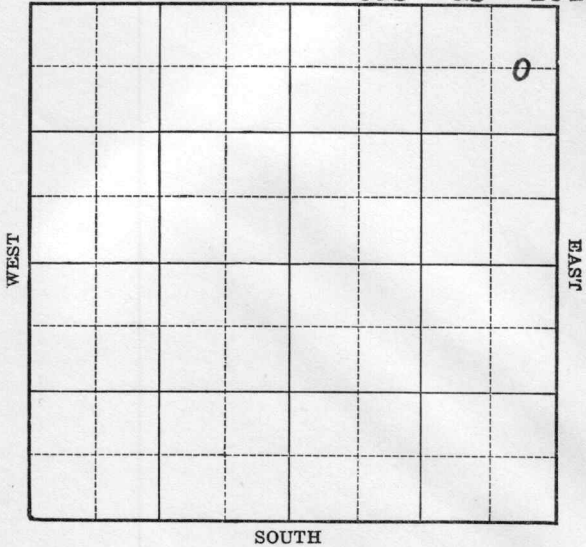

Sec. 22 Twp. 18 R. 16-W

Well No. #3 Maneth-Brackley Farm

Schermerhorn & Winton Company

(Otis Gas Field)


660 Ft. from N. Line

         Ft. from S. Line

330 Ft. from E. Line

         Ft. from W. Line

Elev. 1932

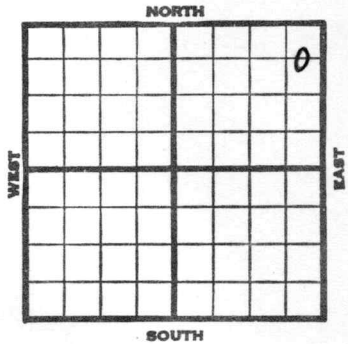

	REPORT
1940	
1/31	15" - 97' 8" & Anhy 988'
	Reagan sand 3529'
	Sat. 3536-43' T.D. 5" - 3543'
	RUST.
2/8	T.D. 3573' No shows.
	P.B. to 3561'
	Shot 56 shots 3518-43'
	48 " 3504-18'
	19-7/10 M cu. ft. gas.
2/14	Reagan 3529'
	5" - 3543'
	T.D. 3573'
	56 shots 3518-43'
	48 " 3508-18'
	21 M cu. ft. gas.
	COMPLETED

Map No. 74 Sec. 22 Twp. 18 R. 16W

Well No. 3 Maneth-Brackley

Schermerhorn & Winton Company

Contractor

FIRST REPORT

SECTION PLAT

C E L N E N E

660 Ft. from N. Line

\_\_\_\_\_ Ft. from S. Line

330 Ft. from E. Line

\_\_\_\_\_ Ft. from W. Line

			o

OTIS GAS FIELD

Location \_\_\_\_\_

Rig up \_\_\_\_\_

Drilling and Remarks:

15" - 97'  
 8" & Anhy. 988'  
 Reagan Sd. 3529  
 Sat. 3536-43 TD.  
 5" 3543; RUST

RECORD

Cased \_\_\_\_\_ in., \_\_\_\_\_ ft.

Sand \_\_\_\_\_

Gas \_\_\_\_\_

Oil \_\_\_\_\_

Total Depth \_\_\_\_\_

PRODUCTION

1st 24 hrs. Nat. \_\_\_\_\_

1st 24 hrs. after shot \_\_\_\_\_

Gas \_\_\_\_\_ Cu. Ft.

Dry Hole \_\_\_\_\_

Abandoned \_\_\_\_\_

Date

JAN 31 1940 19

S. J. LEWIS

Scout

Map No. 74 Sec. 22 Twp. 18 R. 16WWell No. 3 Maneth BrackleySchermerhorn & Winton Company

Contractor

COMPLETED

- C E L N E N E

## SECTION PLAT

			o

660 Ft. from N. Line

\_\_\_\_\_ Ft. from S. Line

330 Ft. from E. Line

\_\_\_\_\_ Ft. from W. Line

OTIS GAS FIELD

Location \_\_\_\_\_

Rig up \_\_\_\_\_

Drilling and Remarks:

*Reagan 3529*  
*5" @ 3543*  
*56 Shots 3518-43*  
*48 " 3508-18*

*21 M Gas*

## RECORD

Cased \_\_\_\_\_ in., \_\_\_\_\_ ft.

Sand \_\_\_\_\_

Gas \_\_\_\_\_

Oil \_\_\_\_\_

Total Depth 3573

## PRODUCTION

1st 24 hrs. Nat. \_\_\_\_\_

1st 24 hrs. after shot \_\_\_\_\_

Gas \_\_\_\_\_ Cu. Ft.

Dry Hole \_\_\_\_\_

Abandoned \_\_\_\_\_

Date

FEB 14 1940 19

S. J. LEWIS Scout