

KANSAS


FORM 51 5M 4-41 PETROL

Rush

Section 23 Township 18 Range 16-W

Well No. 3 Crowell

Company Morgan & Flynn et al

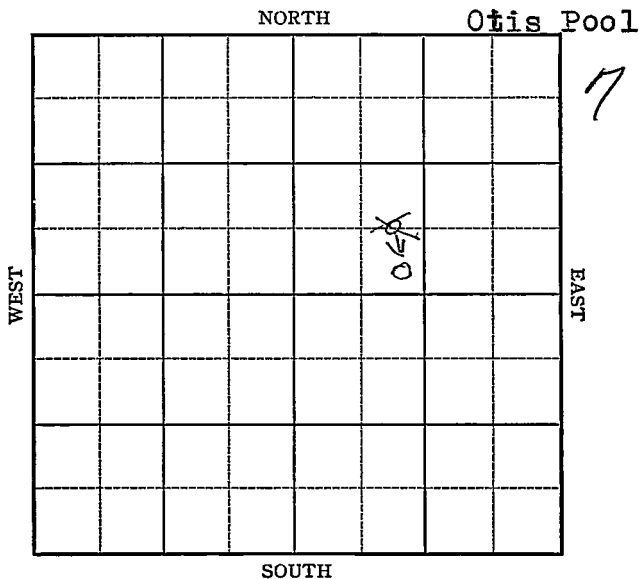

Sec. 23 Twp. 18 R. 16-W

Well No. #3 Crowell Farm

Morgan & Flynn et al Company

(Otis)


330 Ft. from N. Line

~~680~~ Ft. from S. Line

_____ Ft. from E. Line

990 Ft. from W. Line

Elev. 1926

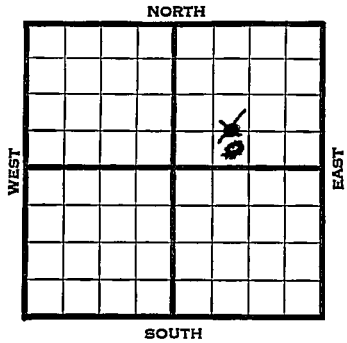

1941	REPORT
7/30	Derrick
8/7	255 Reaming
8/15	15 1/2" - 250' 10" - 980' Drlg. 1470'
8/21	Topeka 2870' Drlg. 3255'
8/28	Reagan 3520' T.D. 3545' S.O. 7" - 3540' RUST.
9/4	1200' oil.
9/11	T.D. 3551 1/2' 50 shots 3524-38' 9 M gas.
9/18	" "
9/24	Reagan 3520' 7" - 3540' T.D. 3553' 50 shots 3524-38' Bomb potential 1272 bbls. 32.5 Gravity
	ABANDONED COMPLETED

Map No. 74 Sec. 23 Twp. 18 R. 16WWell No. 3 CrowellMorgan & Flynn et al Company

Contractor

FIRST REPORT

C E L S W N E

SECTION PLAT

		6	
			2

_____ Ft. from N. Line

660 Ft. from S. Line

_____ Ft. from E. Line

990 Ft. from W. Line

OTIS POOL

Location _____

Rig up _____

Drilling and Remarks:

Derrick

RECORD

Cased _____ in., _____ ft.

Sand _____

Gas _____

Oil _____

Total Depth _____

PRODUCTION

1st 24 hrs. Nat. _____

1st 24 hrs. after shot _____

Gas _____ Cu. Ft.

Dry Hole _____

Abandoned _____

Date

JUL 30 1941 19S. J. LEWIS Scout

Map No. K-74 Sec. 23 Twp. 18 R. 16W

Well No. 3 Crowell

Morgan & Flynn etal Company

COMPLETE Contractor

SE SW NE

SECTION PLAT

_____ Ft. from N. Line

330 Ft. from S. Line

_____ Ft. from E. Line

990 Ft. from W. Line

OTIS POOL

Location _____

Rig up _____

Drilling and Remarks:

Reason 3520
7" @ 3540
5-2440 to 3524-38
Boon & A. Y. 1272

325 Gr

RECORD

Cased _____ in., _____ ft.

Sand _____

Gas _____

Oil _____

Total Depth 3553

PRODUCTION

1st 24 hrs. Nat. _____

1st 24 hrs. after shot _____

Gas _____ Cu. Ft.

Dry Hole _____

Abandoned _____

Date

SEP 24 1941 19

S. J. LEWIS Scout