

KANSAS


FORM 51 5M PETROL

Trego

Section 1 Township 13 Range 21-W

Well No. #1 A. Cronb

Company Stanolind

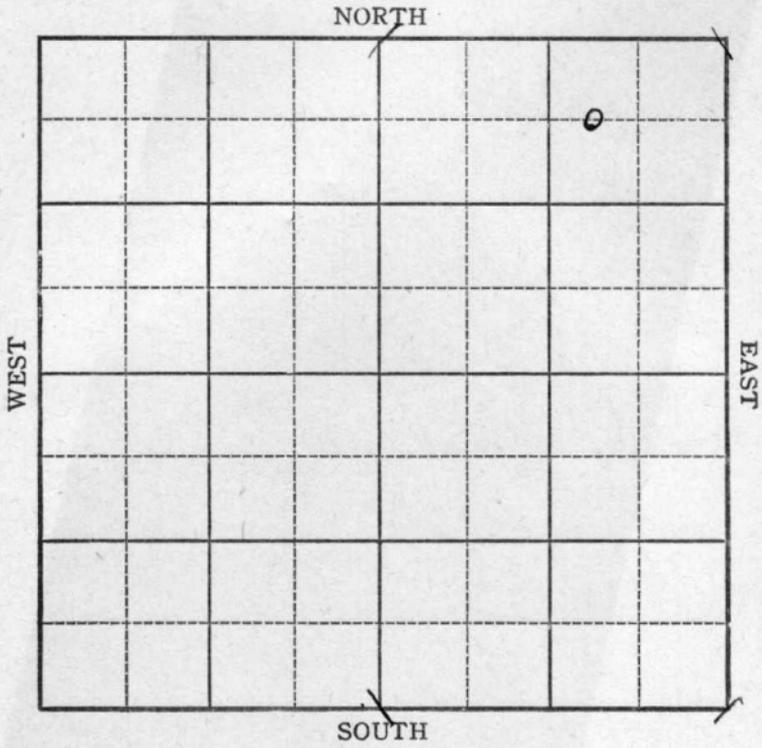

Sec. 1 Twp. 13 R. 21-W

Well No. #1 A Cronb Farm

Stanolind Company


660 Ft. from N. Line

_____ Ft. from S. Line

990 Ft. from E. Line

_____ Ft. from W. Line

Elev. 2184

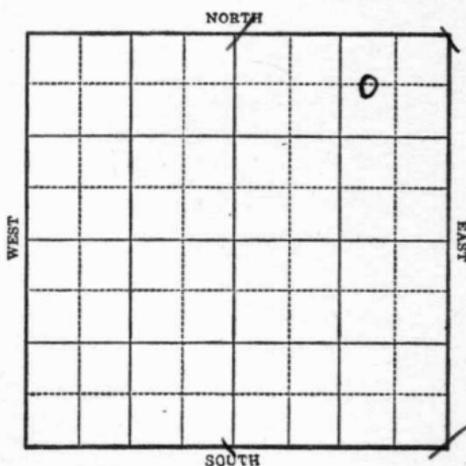

1943

R E P O R T

10/20 Rotary

10/27 100 SD

11/3 13" @ 1121
8 @ 1183
Drlg. 1925'

11/10 Andy 1572
Topeka 3188
Lans 3460
Drlg. 3535'

11/17 BkC 3713
Arb 3818
5" @ 3818
Td 3830 SO

11/24 2000 Acid
swab 40 oil in 24 hrs.

12/1 TD 3850
40 qts 3828-40 1000' oil

12/8 5" @ 2818
Arb 3818
7200 acid
Pump 100 Pot.
T.D. 3850'
Gravity 31

COMPLETED

Trego

KANSAS

Map No. 70 Sec. 1 Twp. 13 R. 21W

Well No. 1 A. Cronb

Stanolind

Company

FIRST REPORT

Contractor

C W L NE NE


SECTION PLAT

660 Ft. from N. Line

Ft. from S. Line

990 Ft. from E. Line

Ft. from W. Line

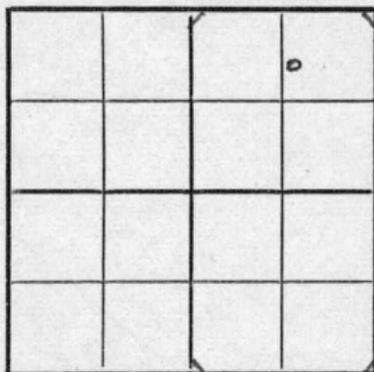

Ellis Pool

Location

Rig up

Drilling and Remarks:

Rotary

RECORD

Cased in., ft.

Sand

Gas

Oil

Total Depth

PRODUCTION

1st 24 hrs. Nat.

1st 24 hrs. after shot

Gas Cu. Ft.

Dry Hole

Abandoned

Date

OCT 20 1943 19

S. J. LEWIS Scout

Trego

Map No. KANSAS 70 Sec. 1 Twp. 13 R. 21W

Well No. 1 A. Cromb

Stanolind Company

COMPLETED Contractor

C W L N E N E

SECTION PLAT

660 Ft. from N. Line

_____ Ft. from S. Line

990 Ft. from E. Line

_____ Ft. from W. Line

			a

Ellis Pool

Location _____

Rig up _____

Drilling and Remarks:

CU 83818
5" @ 3878
7200 cu ft
Pump 100 Pst
30° Gr

RECORD

Cased _____ in., _____ ft.

Sand _____

Gas _____

Oil _____

Total Depth 3850

PRODUCTION

1st 24 hrs. Nat. _____

1st 24 hrs. after shot _____

Gas _____ Cu. Ft.

Dry Hole _____

Abandoned _____

Date

DEC 8 1943 19

S. J. LEWIS Scout