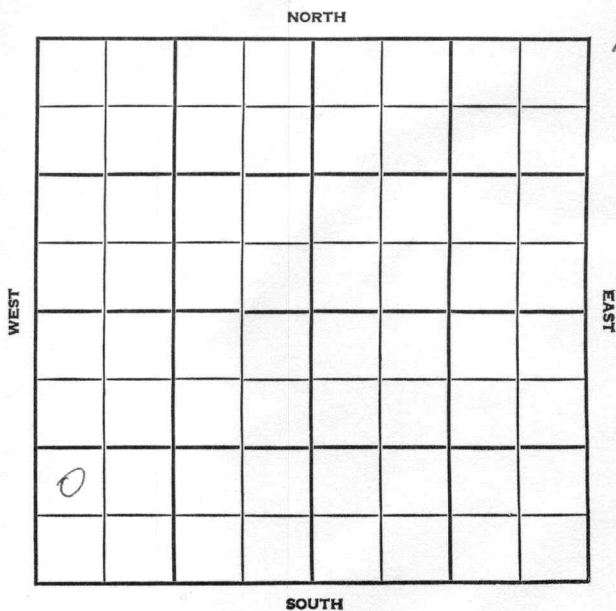


Section 22 Township 18 Range 16WWell No. #2 SchneiderCompany Welch & Olsson

Rush

KANSAS

SEC.

TWP.

R.

22

18

16W

WELL NO.

#2 Schneider

FARM

COMPANY

Welch & Olsson

CONTRACTOR

Co. Tools

Otis-Albert

____ FT. FROM N. LINE

____ FT. FROM S. LINE

____ FT. FROM E. LINE

____ FT. FROM W. LINE

NW SW SW

NORTH

WEST

EAST

SOUTH

ELEVATION

1956

1967'

REPORT

7-3

MIR

8-1

Comm. 7-3-56

8 5/8" @ 1011 w/450

5 1/2" @ 3589 w/75

24/3564-70

FU 500' oil

S/ 6 1/2 boph, no/wtr.

Sw/ 2 1/2 boph, no/wtr.

P/ 25 bopd, no/wtr.

H. 3185'; Tr. 3203'; Dg. 3218';

L. 3248'; BKG 3471'; C. 3507';

Rea. sd. 3538';

TD 3590'

COMPLETED

14

County Rush Elev. _____
 Sec. 22 Twp. 18 Rge. 16W
 Company Welch & Olsson
 Farm Name Schneider No. 2

TOPS	DEPTH	LOG	DATUM
------	-------	-----	-------

Anh.			
Tr.			
H.			
Tr.			
Dg.			
Bl.			
L.			
K.C.			
B.K.C.			
Ce.			
C.			
M.			
M.			
K.			
Mz.			
Mq.			
V.			
S.			
S.			
A.			
R.			
Pe.			
G.			
T.D.			

Loc. in Sec. _____

NW SW SW

Geol. _____

Contr. _____

Co. tools

Pool

Otis-Albert

FIRST REPORT

JUL 3 '56

Date Comm.

M I R

JUL 1 1956

R. G.

Co.

Use.

No.

Sec.

T.

R.

County

Rush

Elev.

1967

Sec.

22

Twp.

18

Rge.

16W

Company

Welch & Olsson

Farm Name

Schneider

No. 2

TOPS

DEPTH

LOG

DATUM

Loc. in Sec.

Anh.

Tp.

H.

Tr.

Dg.

BL.

L.

K.C.

B.K.C.

Ce.

C.

M.

M.

K.

Mz.

Mq.

V.

S.

S.

A.

R.

P.

G.

T.D.

3185

3203

3218

3248

3471

3507

3538

3538

3590

NW SW SW

Geol.

Contr.

Co. tools

Pool

Otis-Albert

COMPLETE

Date Comm.

AUG 1 1956

M I ? JUL 11 '56

7-3-56 8581011

1450 JUL 18 '56 5 1/2 @ 3589 / 75 MUCF

24 / 3564-70 FU 500' oil &

6 1/2 Boph no/w JUL 25 '56 & 2 1/2

Boph no/w to Pop AUG 1 '56 P. 25

Bopd no/w to